

# APPLICATION

for

SIDE SEWER PERMIT


CARD No. \_\_\_\_\_

The City of Mountlake Terrace

OUTSIDE ☐ INSIDE ☒ REPAIRS ☐

EASEMENT No. \_\_\_\_\_

OWNER Wick Horner, Inc. CONTRACTOR Lynnwood Septic Tank Co. PERMIT No. \_\_\_\_\_  
 STREET \_\_\_\_\_  
 HOUSE No. 21501 54th pl S W AVENUE LOT No. Lot 7 BLOCK No. Job-11  
 NAME ADD. Sharlott

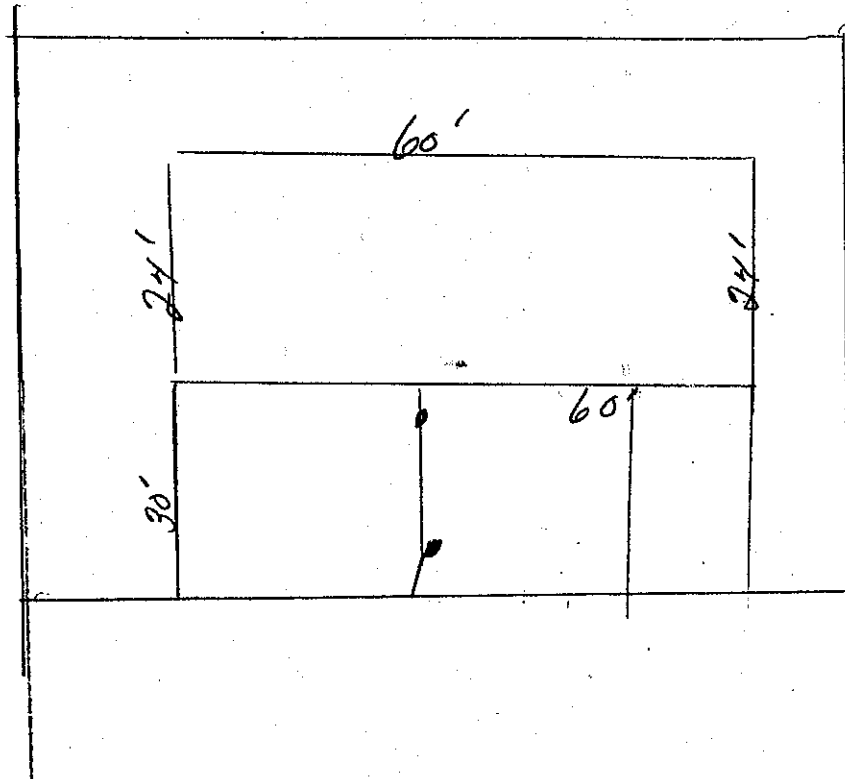

BACKFILL WORK ORDER ISSUED \_\_\_\_\_ DEPOSIT, \$ \_\_\_\_\_  
 SEWER WORK ORDER ISSUED \_\_\_\_\_

Approved:

DATE 6-26-64 BY George W. Baker