

# APPLICATION

CARD No. \_\_\_\_\_

## SIDE SEWER PERMIT

OUTSIDE ☐ INSIDE ☐ REPAIRS ☐

EASEMENT No. \_\_\_\_\_

The City of Mountlake Terrace

OWNER Loren Lingquist

CONTRACTOR Larrys Drain Field + Sewer


PERMIT No. \_\_\_\_\_

HOUSE No. 3610 - 222nd SW

STREET  
AVENUE LOT No. 1

BLOCK No. 14

NAME ADD. Adair Grove

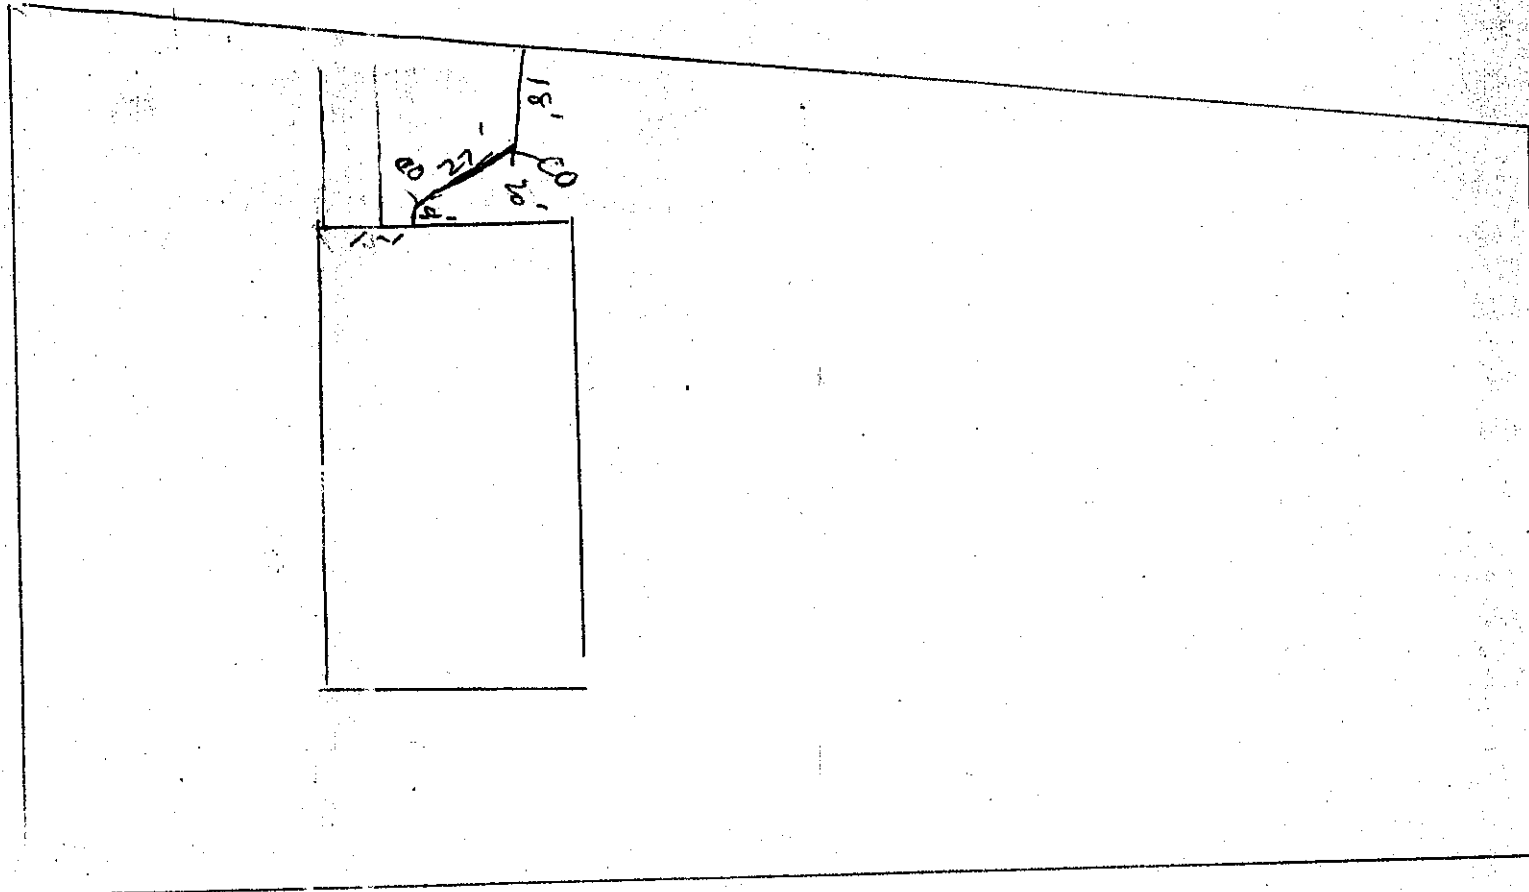

Date

Approved:

BACKFILL WORK ORDER ISSUED \_\_\_\_\_

DEPOSIT, \$

10.00

SEWER WORK ORDER ISSUED \_\_\_\_\_

DATE

BY

*[Signature]*