

THE CITY OF MOUNTLAKE TERRACE

APPLICATION

FOR

SIDE SEWER PERMIT

OUTSIDE ☐ INSIDE ☐ REPAIRS ☐


CARD No. _____

EASEMENT No. _____

OWNER Pace Setter Const CONTRACTOR Lynnwood Septic Tank PERMIT No. 4149

HOUSE No. 6806 - 226 PC SW STREET AVENUE LOT No. 26 BLOCK No. _____

NAME ADD Lake Ballinger Homes #3

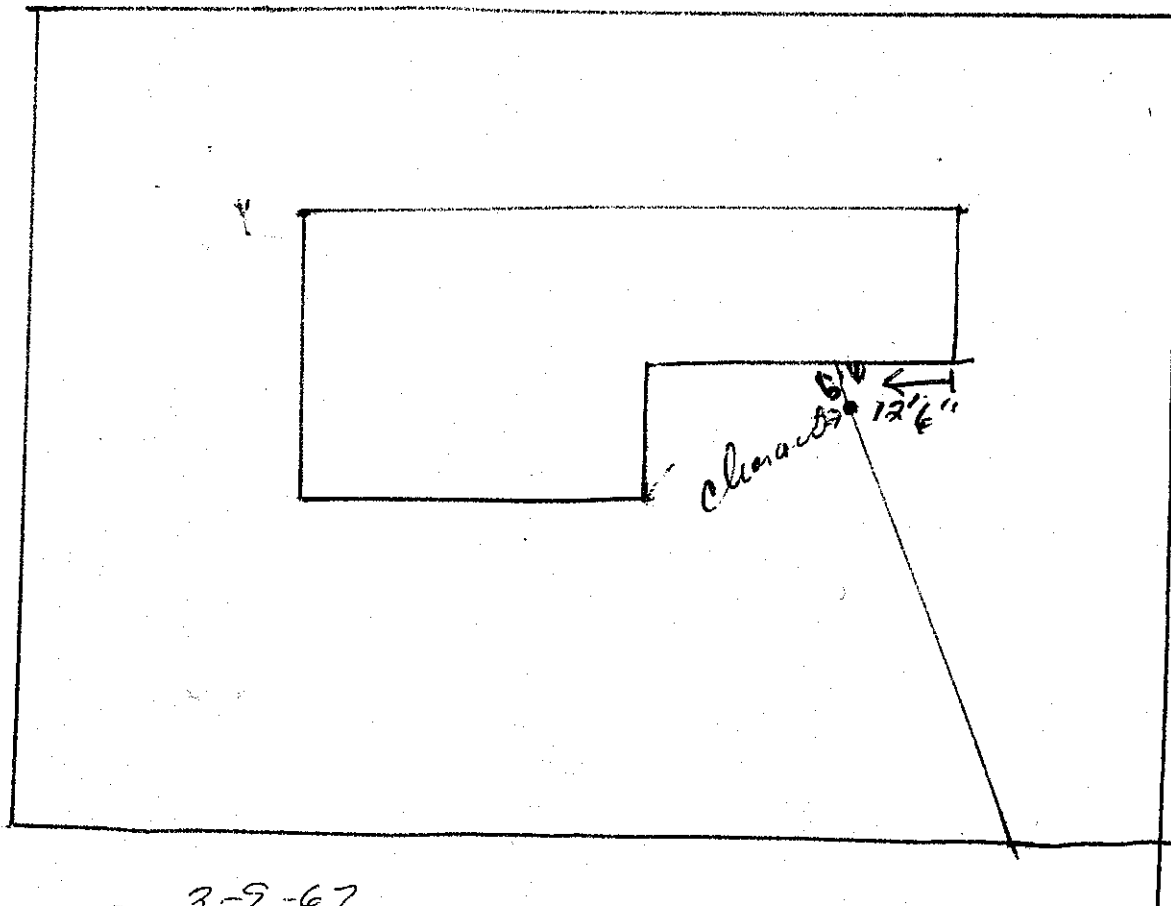

DATE 3-9-67 DEPOSIT. \$ 10.00

BACKFILL WORK ORDER ISSUED _____

SEWER WORK ORDER ISSUED _____

APPROVED:

DATE _____ BY _____