

APPLI ION

for

CARD No. _____

SIDE SEWER PERMIT

The City of Mountlake Terrace

OUTSIDE ☐ INSIDE ☐ REPAIRS ☐


EASEMENT No. _____

OWNER Parkwood Homes Inc
 HOUSE No. ~~5401~~ - 2195W
4409

CONTRACTOR Lynnwood Septic tank co
 STREET _____
 AVENUE LOT No. # 5
 NAME ADDR Parkwood Homes

PERMIT No. _____

BLOCK No. _____

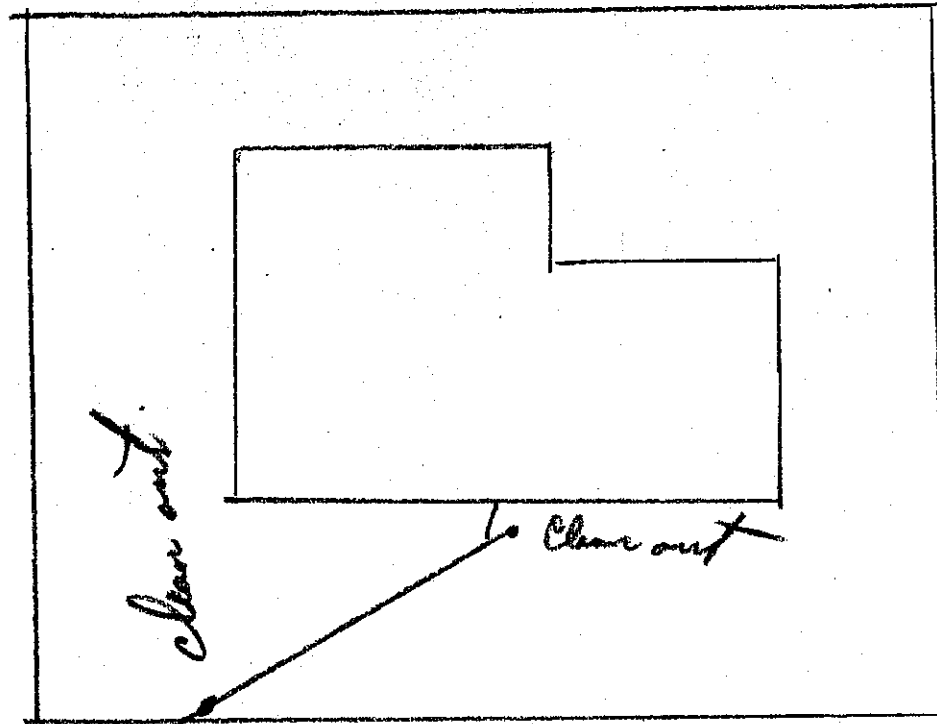

BACKFILL WORK ORDER ISSUED _____

DEPOSIT, \$

10.00

Approved:

DATE

5-3-66

BY

[Signature]