


PLAN	SURVEYED	DATE
	NOTED	CHECKED
PROFILE	NOTED	DATE
	NOTED	CHECKED


PLAN	SURVEYED	DATE
	NOTED	CHECKED
PROFILE	NOTED	DATE
	NOTED	CHECKED

PLAN	SURVEYED	DATE
	NOTED	CHECKED
PROFILE	NOTED	DATE
	NOTED	CHECKED

PLAN	SURVEYED	DATE
	NOTED	CHECKED
PROFILE	NOTED	DATE
	NOTED	CHECKED

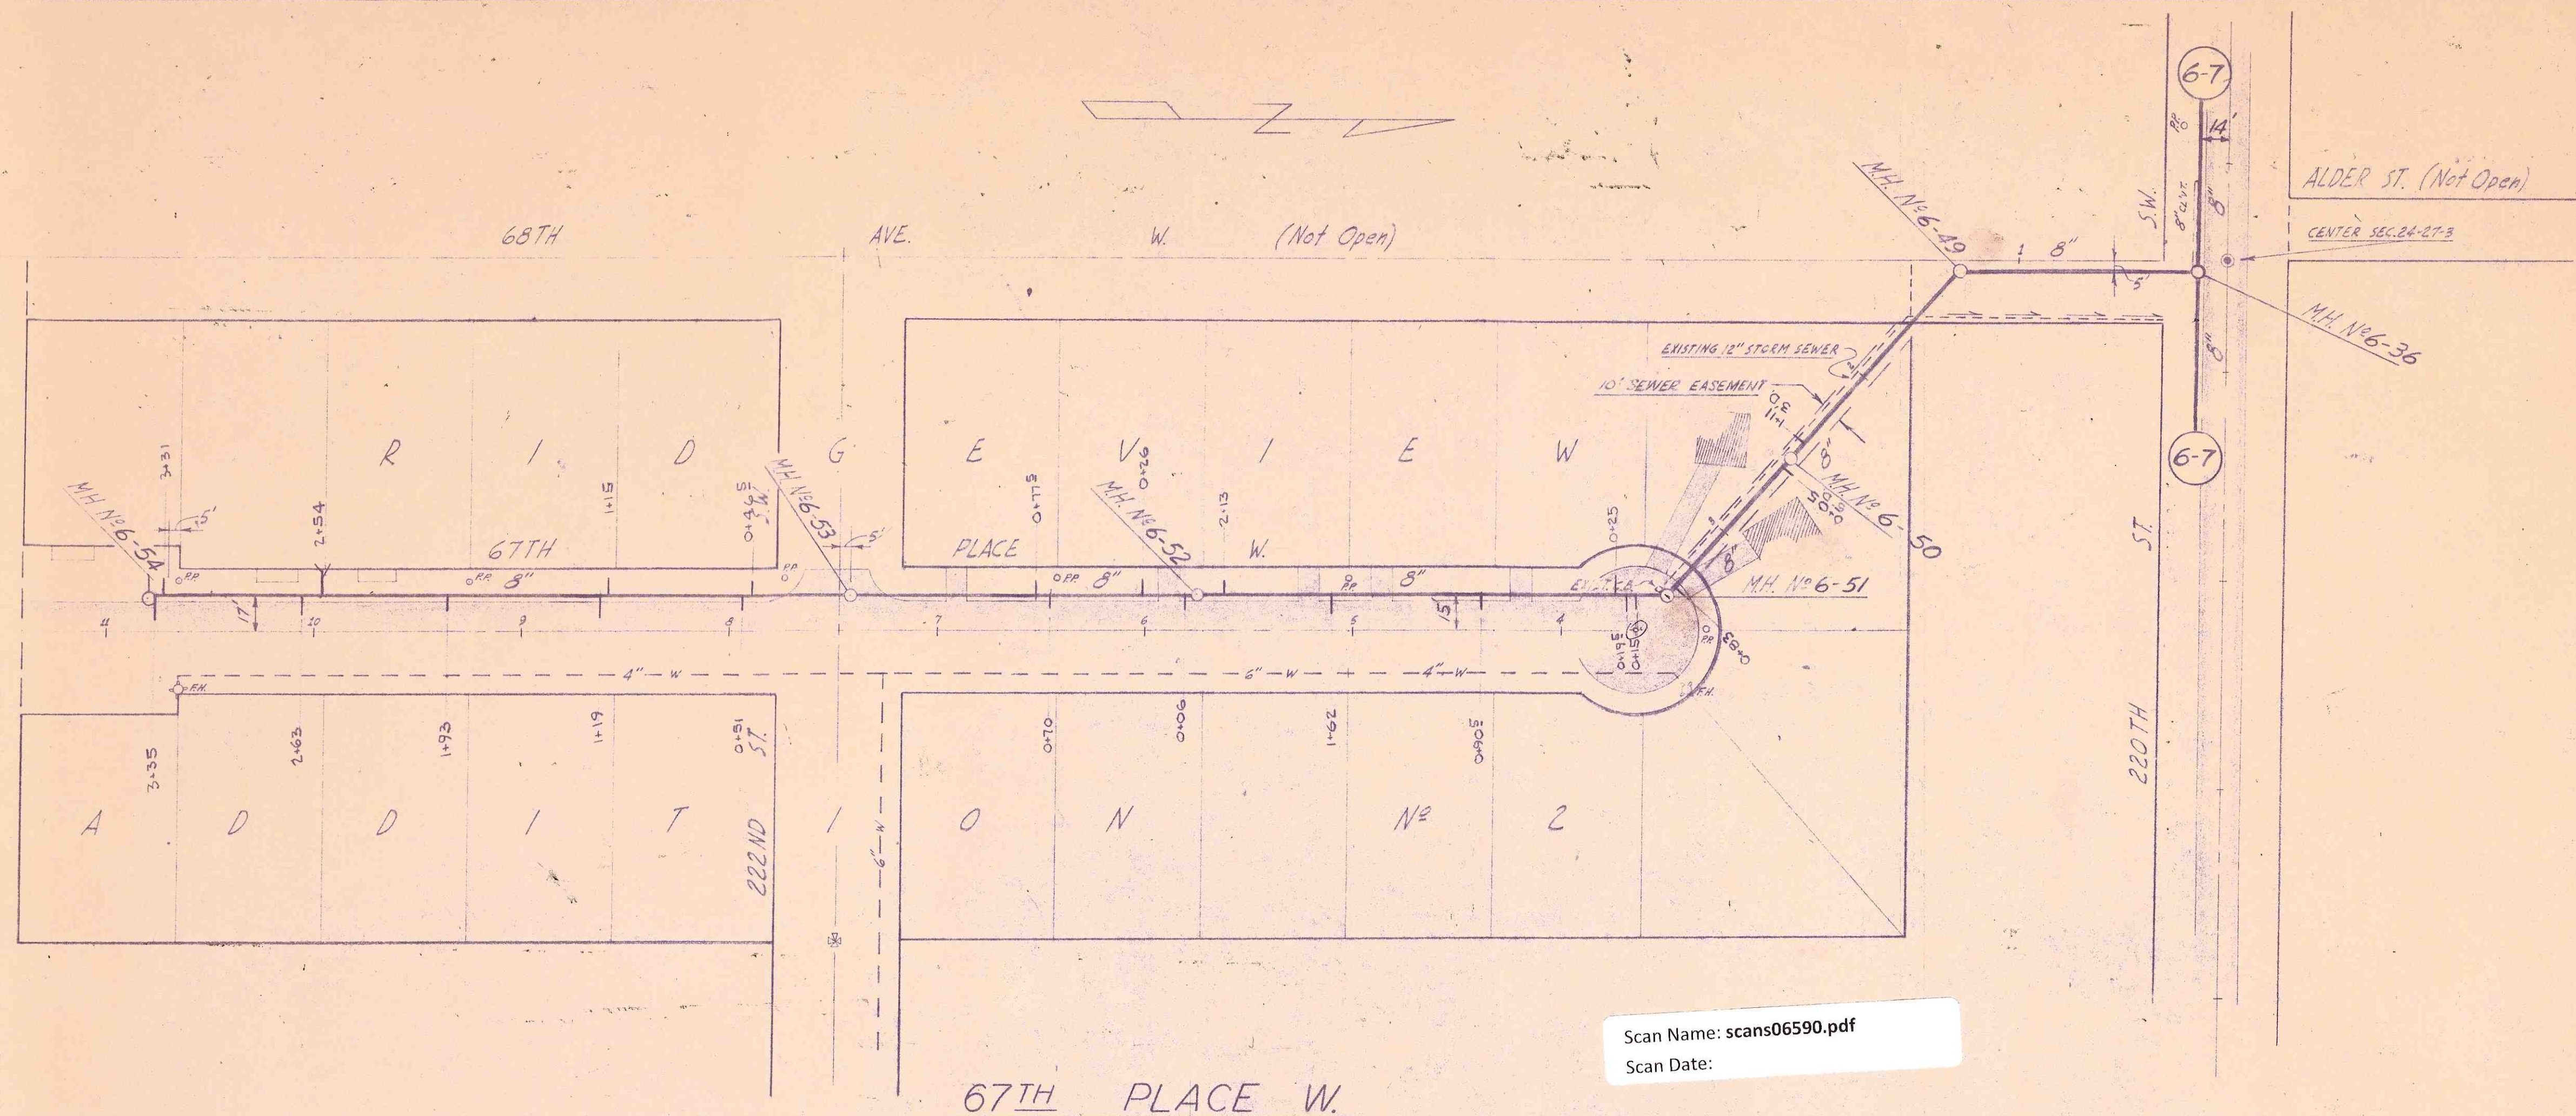

Scan Name: scans06590.pdf
Scan Date:

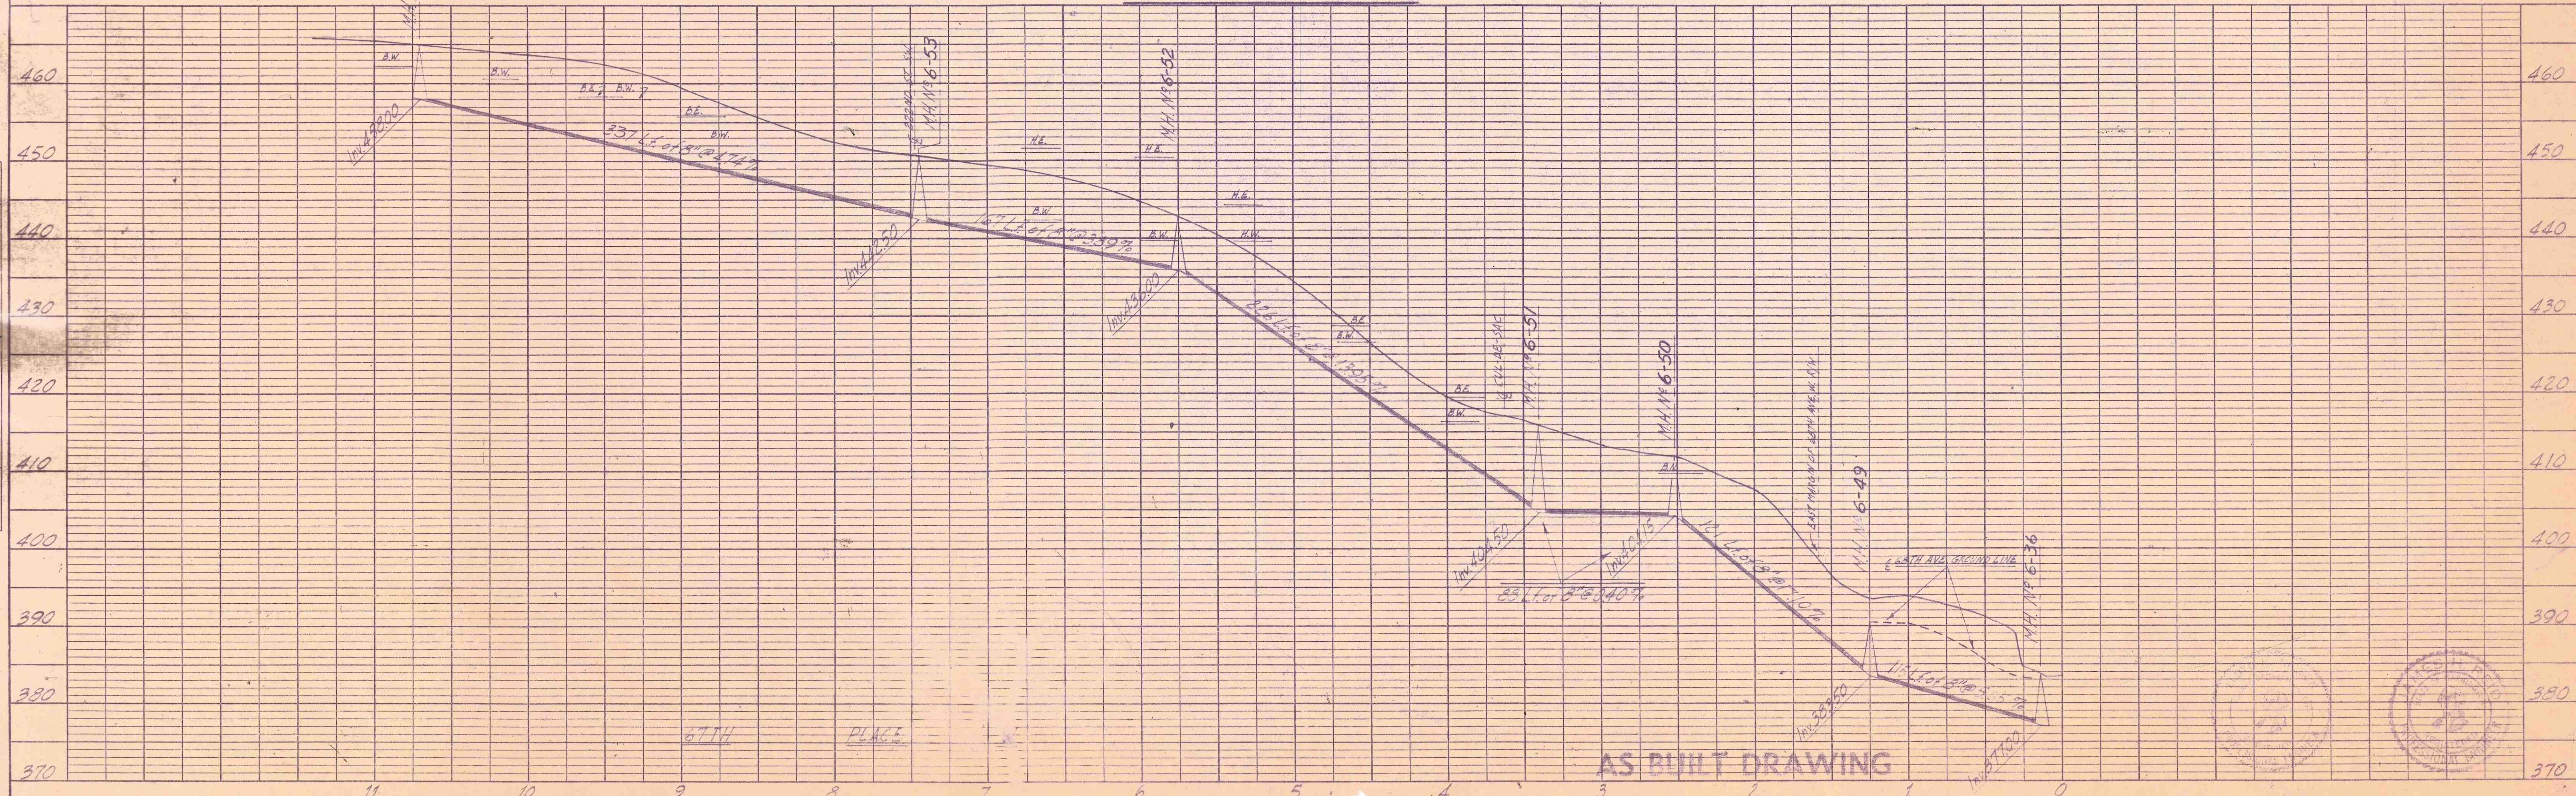

AS BUILT DRAWING

PLATE 1-PLAN-PROFILE
CLEARPRINT PAPER CO., S.F.
No. 1000-1

JAMES H. REID & ASSOCIATES
CONSULTING ENGINEERS, 324 MAIN ST., EDMONDS, WASH.

DESIGN	DRAWN	CHECKED	DATE	H. SCALE	V. SCALE	FILE NO.
Paulson	Paulson	Nelson	5-4-62	1/4"=50'	1"=10'	5.50 / 6 / 9

CITY OF MOUNTLAKE TERRACE
SEWERAGE SYSTEM UNIT 6