

The City of Mountlake Terrace

APPLICATION

for

SIDE SEWER PERMIT

OUTSIDE ☒ INSIDE ☐ REPAIRS ☐

CARD No. 2412

EASEMENT No. 2412

OWNER JOHN FLUKE MFG. CO. INC.

CONTRACTOR ANGELO LOSSREPO

PERMIT No. 2412

HOUSE No. 7001 220TH ST. S.W. AT 68TH AV.


STREET

AVENUE LOT No.

BLOCK No. 7000

NAME ADD.

SEWER MAIN (TYPED)

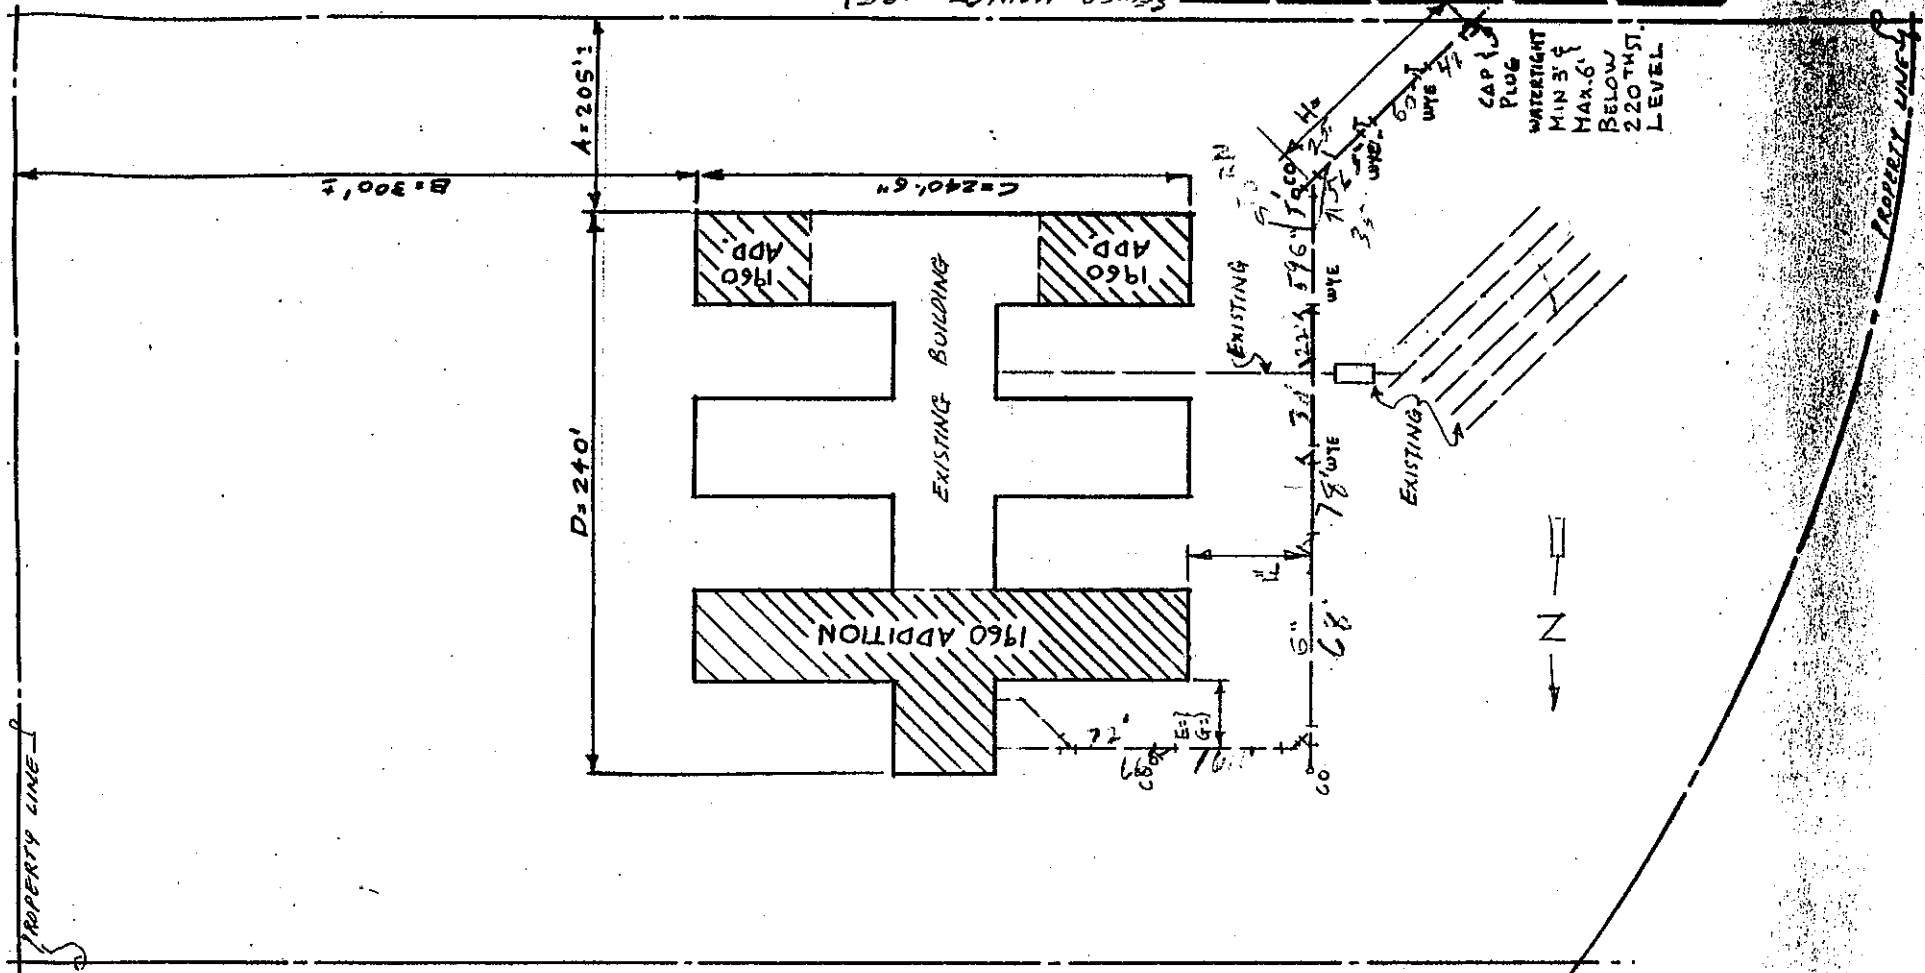

Date

Approved:

BACKFILL WORK ORDER ISSUED June 20TH '60 DEPOSIT, \$ 10.00

SEWER WORK ORDER ISSUED June 20TH '60 # 1643

DATE

BY