


PLAN	DATE	BY
NOTE BOOK	DATE	BY
NOTE BOOK	DATE	BY

PROFILE	DATE	BY
NOTE BOOK	DATE	BY
NOTE BOOK	DATE	BY

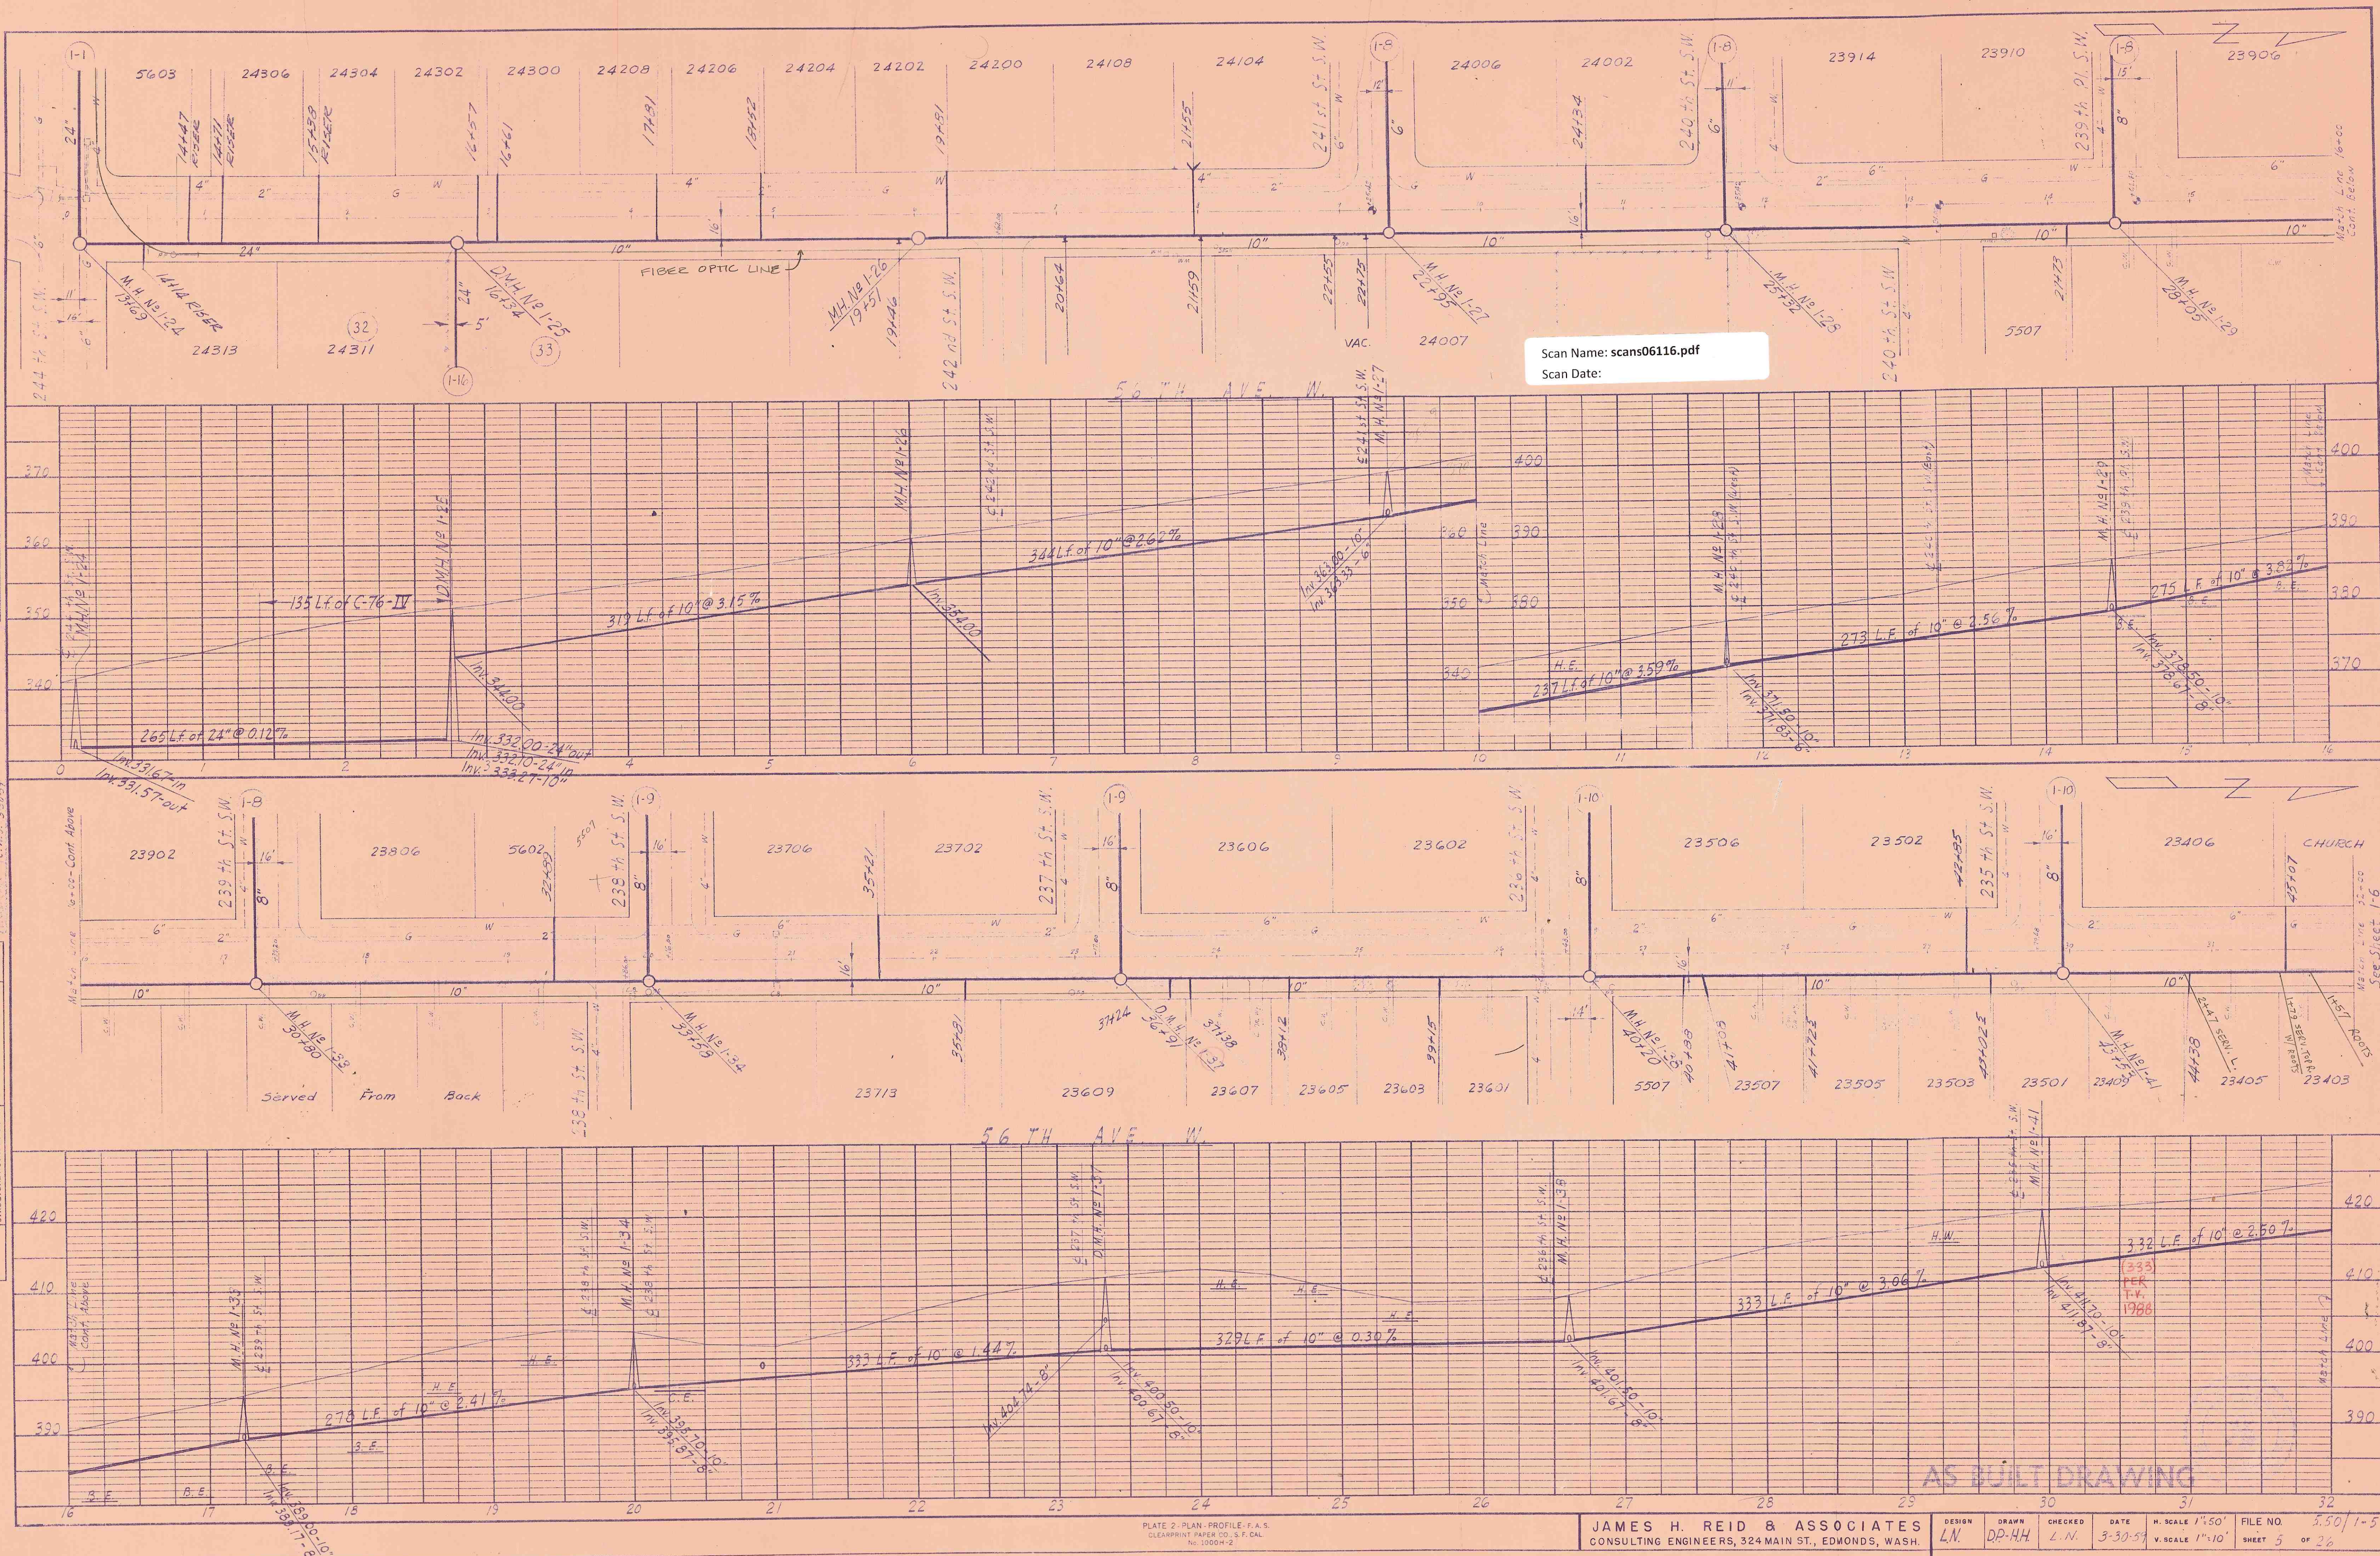

Scan Name: scans06116.pdf
Scan Date:

AS BUILT DRAWING

JAMES H. REID & ASSOCIATES
CONSULTING ENGINEERS, 324 MAIN ST., EDWARDS, WASH.

DESIGN	DRAWN	CHECKED	DATE	H. SCALE	V. SCALE	FILE NO.
LN	DP-HH	LN	5-30-57	1"=50'	1"=10'	5501-5

CITY OF MOUNTAIN VIEW
SEWERAGE SYSTEM UNIT I