


Pinned & Telephone cables, conduit, etc.  
to be in same trench except as noted  
in front of lots 7, 8, 9, 12

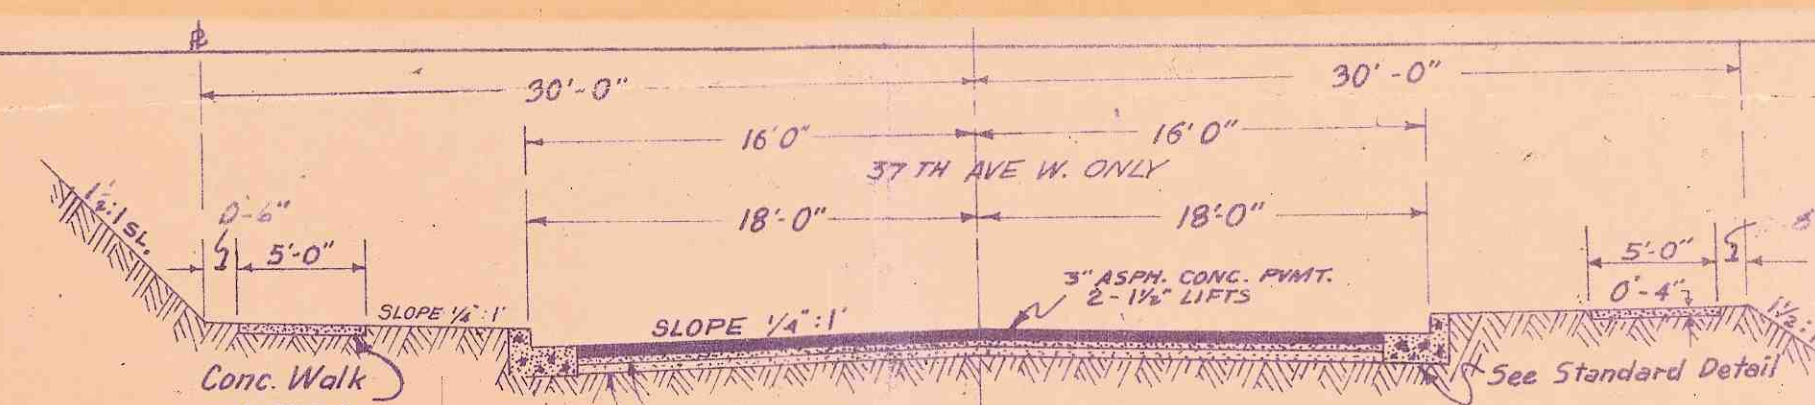

NOTE: WATER 13' N & E OF & ROADS  
SEWER 5' S & W OF & ROADS  
GAS 21' E & W OF & ROADS

**NOTE:** WATER 13' N & E OF E ROADS  
SEWER 5' S & W OF E ROADS  
GAS 21' E & W OF E ROADS

Approved: Allen E. Feltz  
Snohomish County P.U.D.

Approved: Con. R. Viereck  
General Telephone Co. of the Northwest

Approved: Paul H. Hill  
Washington Natural Gas Co.

Approved:

ROADWAY SUR.

DETAIL  
Concrete Curb & Gutter.

SCALE : 1" = 50'

1	ELEV EQUATION: AS BUILT STAKE, REUSE 37.74	FORM 28-01	P. 1
3	ADD SLOPE STAKES - ADD GEOMETRIC POINTS	ADJUST-0.1	P. 2
2	REMOVE BUBBLE IN C/L ON SLOPE	ADJUST 0.1	P. 3
1	WATERMAIN 6" TO 8" - ADD BLOWN STAKE	ADJUST 0.1	P. 4

RUSKIN FISHER & ASSOCIATES, INC.

CIVIL ENGINEERS LAND SURVEYORS  
17962 MIDVALE AVE. N. SEATTLE, WASH.

BALCH & COGLAS CEDARGROVE NO.2

PLAN-PROFILES-ROADS

STORM DRAINAGE, SANITARY SEWERS

### STORM DRAINAGE, SANITARY SEWERS & UTILITIES

CITY OF MOUNTLAKE TERRACE, WASHINGTON

DRAWN BY P.L. DATE 6-9-67 JOB NO. 67627

CHECKED BY \_\_\_\_\_ DATE \_\_\_\_\_  
APPROVED BY \_\_\_\_\_ DATE \_\_\_\_\_

Engr. - City of Mountlake Terrace SHEET 1 OF 2

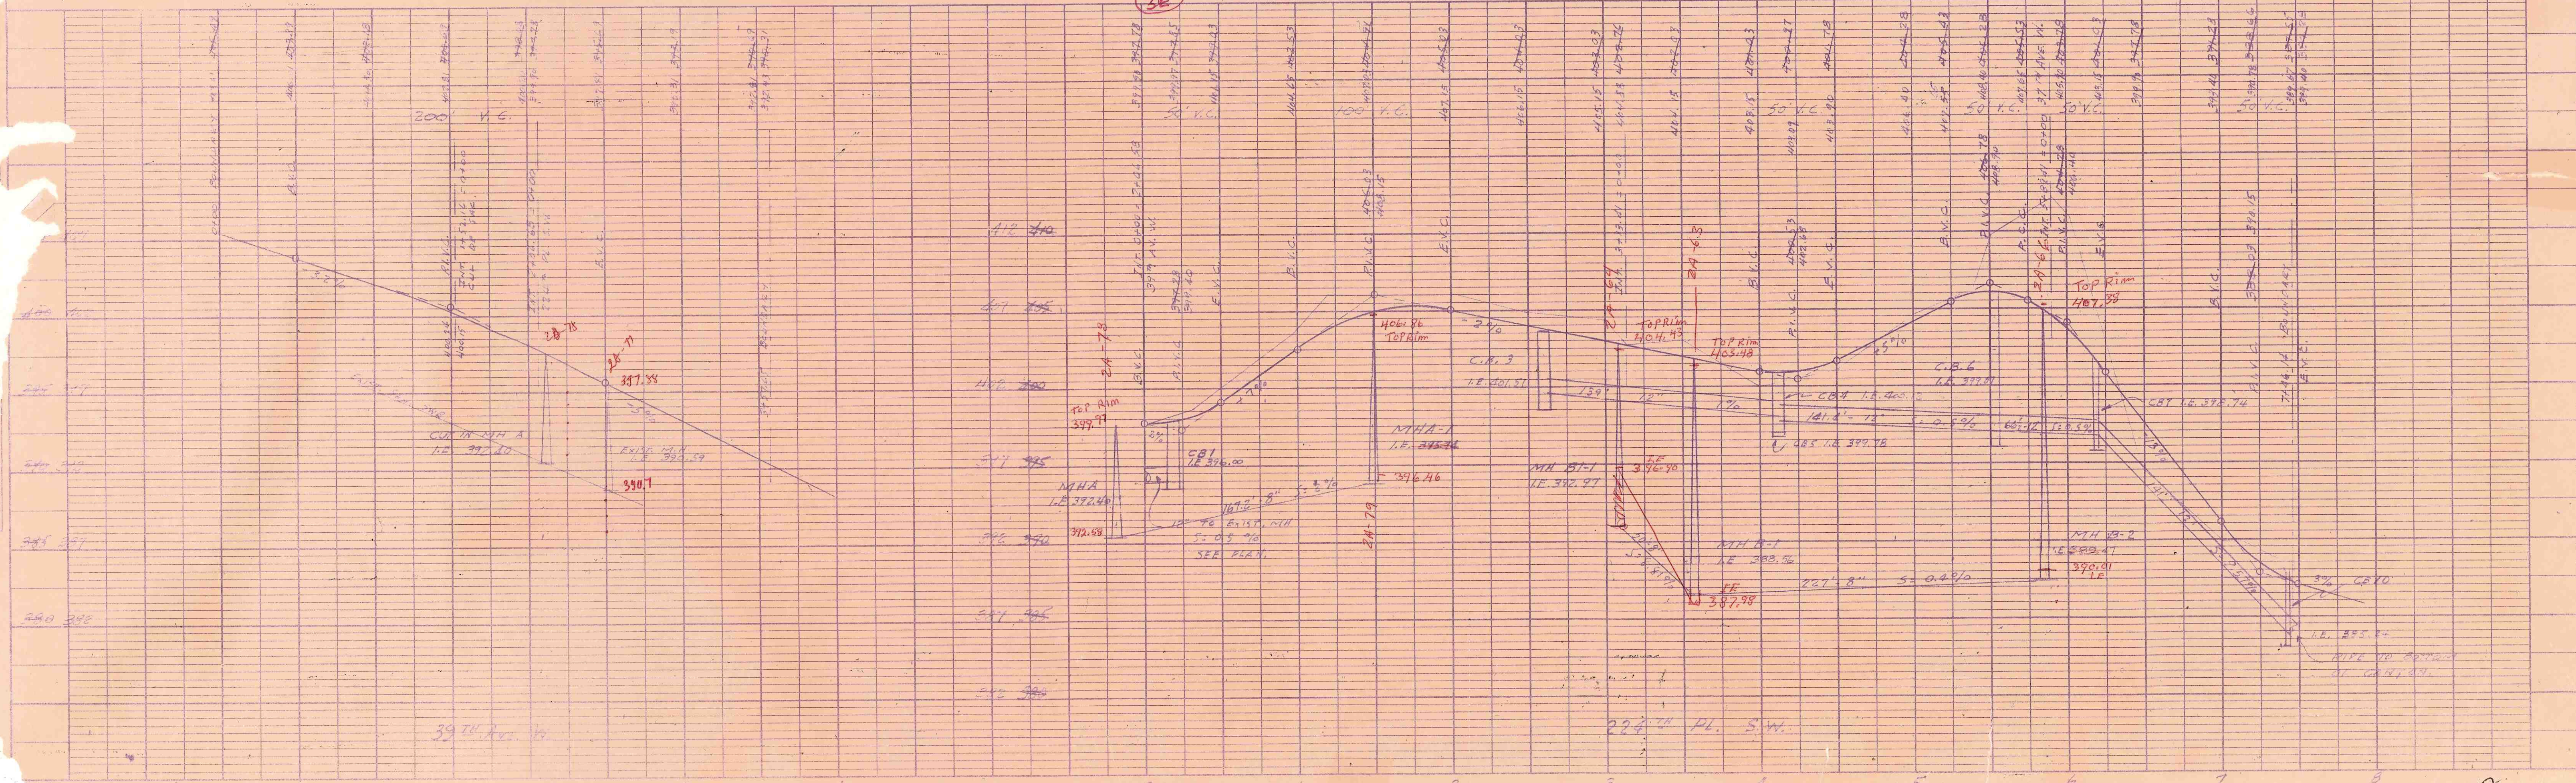


PLATE 1 - PLAN - PROFILE - F.A.S.  
CLEARPRINT PAPER CO., S.F. CAL.

2A-17