

The City of Mountlake Terrace

APPL ION

for

SIDE SEWER PERMIT

OUTSIDE ☒ INSIDE ☐ REPAIRS ☐

CARD No.

EASEMENT No.

1858294

OWNER Hugh C. Henderson

CONTRACTOR

Russ's Septic Service

PERMIT No.

2320

HOUSE No. 23003 - 59" W.

STREET

AVENUE LOT No.


2

BLOCK No.

7

NAME ADD.

Mountlake Terrace Div. No. 15

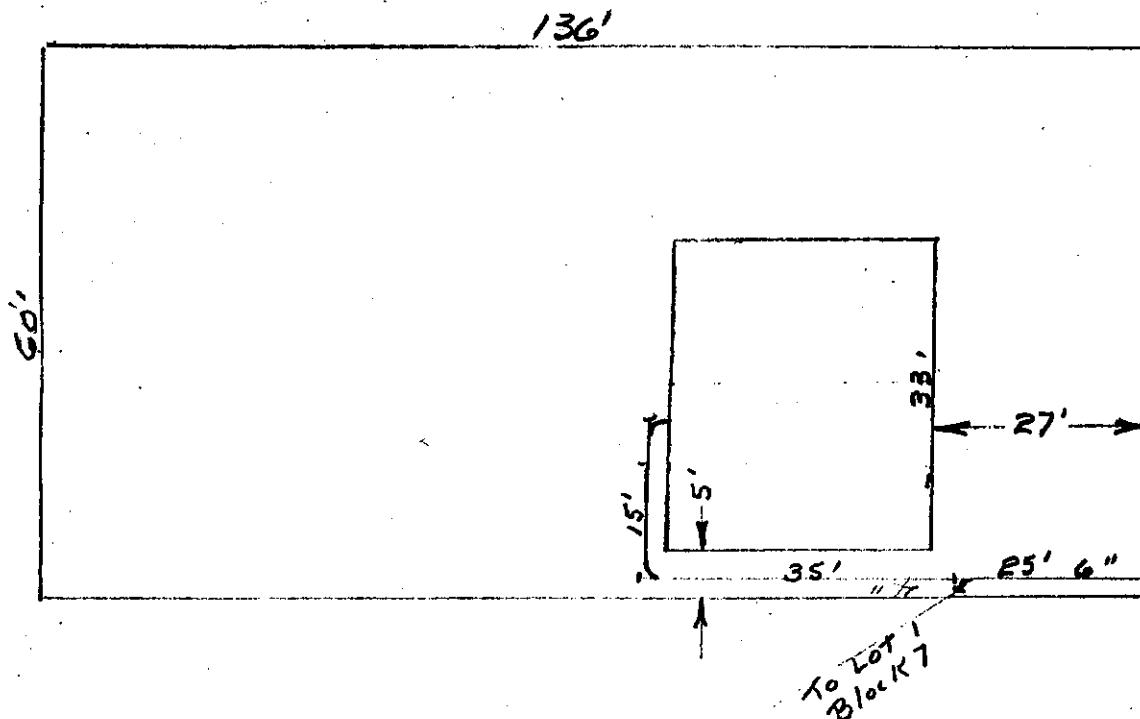

59 W

CITY OF  
MOUNTLAKE TERRACE

APR 1 1960

Plan Approved

Date

BACKFILL WORK ORDER ISSUED

DEPOSIT, \$10.00

3/31/60

Approved:

SEWER WORK ORDER ISSUED

1096

DATE

7/6/60

BY

J. Turner