


DATE: 2/14/54
 BY: J.H.R.
 CHECKED: J.H.R.
 DESIGNED: J.H.R.
 PLANNED: J.H.R.
 NOTE: BOOK, PLANS, CHECKED
 NO. 1000-2
 STRUCTURE NOTATION: CHKD

DATE: 2/14/54
 BY: J.H.R.
 CHECKED: J.H.R.
 DESIGNED: J.H.R.
 PLANNED: J.H.R.
 NOTE: BOOK, PLANS, CHECKED
 NO. 1000-2
 STRUCTURE NOTATION: CHKD

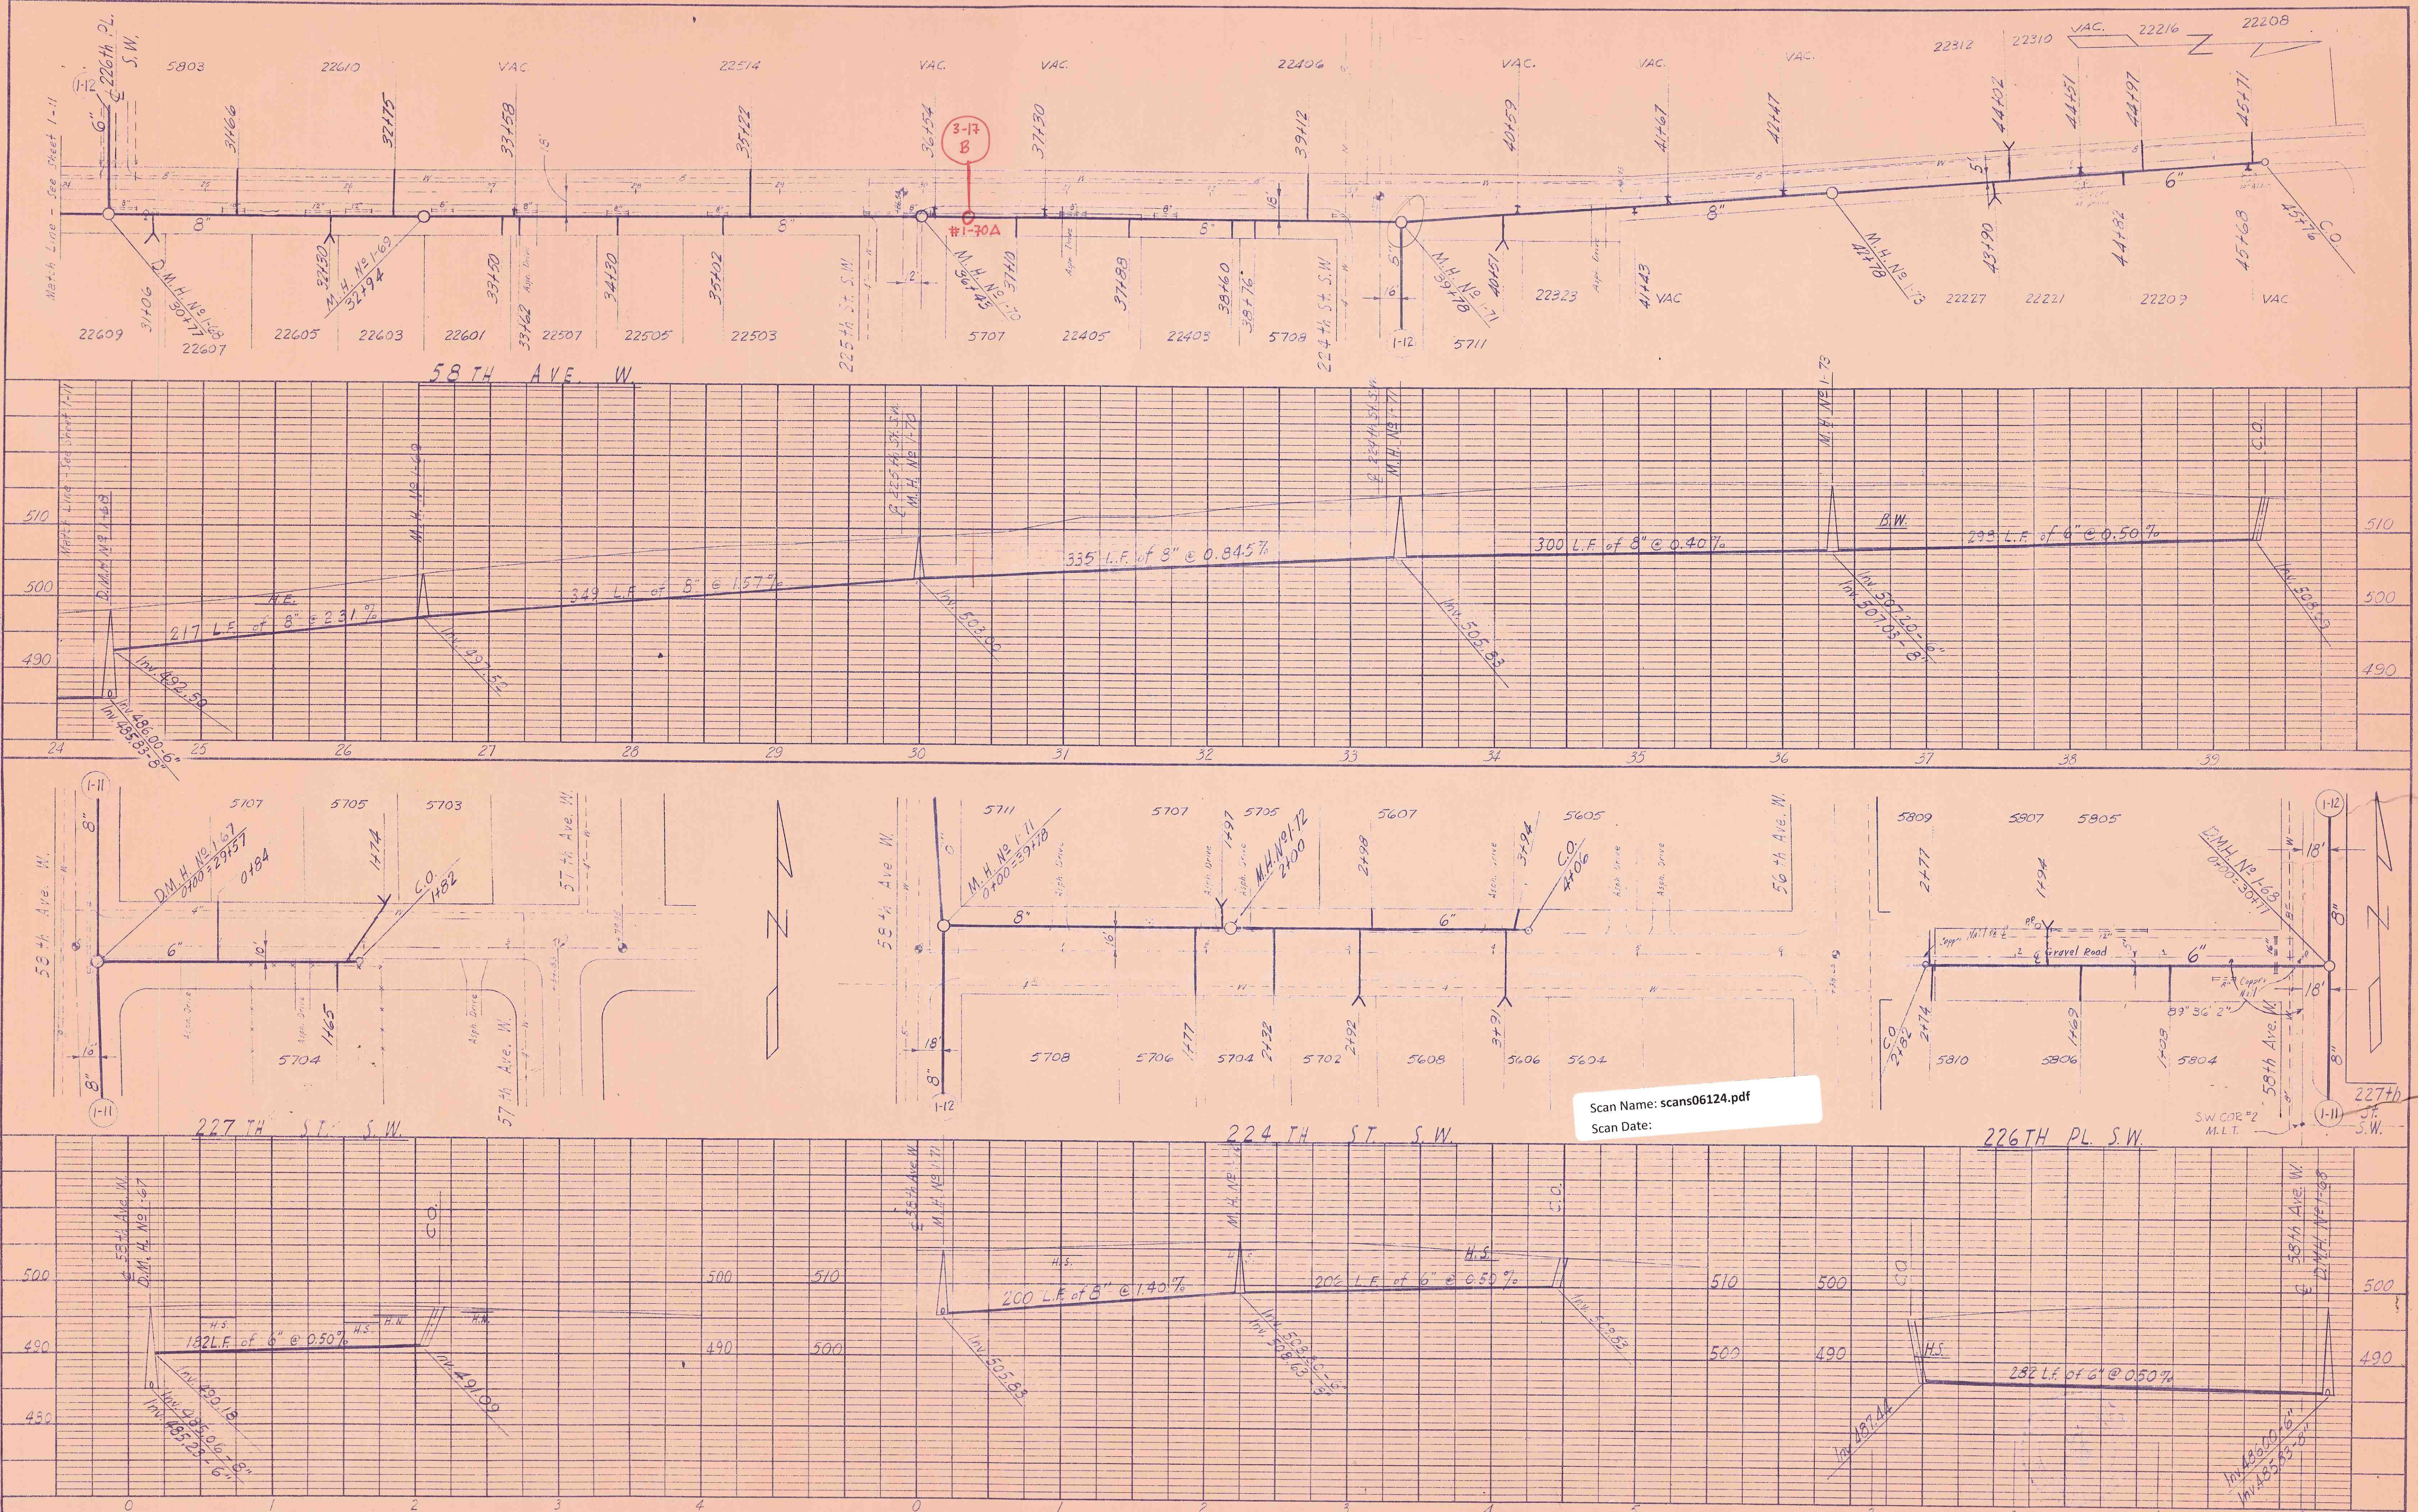

Scan Name: scans06124.pdf
 Scan Date:

PLATE 2-PLAN-PROFILE-F.A.S.
 CLEARPRINT PAPER CO. S.F. CAL.
 NO. 1000H-2

JAMES H. REID & ASSOCIATES
 CONSULTING ENGINEERS, 324 MAIN ST., EDMONDS, WASH.

DESIGN: L.N. DRAWN: D.P.-M.H. CHECKED: L.N. DATE: 3-30-54 H. SCALE: 1"=50' V. SCALE: 1"=10' FILE NO.: 550/1-12 SHEET 12 OF 26

AS BUILT DRAWING

CITY OF MOUNTAIN LAKE TERRACE
 SEWERAGE SYSTEM UNIT 1