

The City of Mountlake Terrace

APPLICATION

for

SIDE SEWER PERMIT

OUTSIDE ☐ INSIDE ☒ REPAIRS ☐

2193

CARD No. _____

EASEMENT No. _____


OWNER Elmer V Moss

CONTRACTOR Lynnwood Septic Tank Co PERMIT No. 3074

HOUSE No. ~~4500~~ 24302

STREET
AVENUE LOT No. 24302 - 45 Ave BLOCK No. 28

NAME ADD. _____

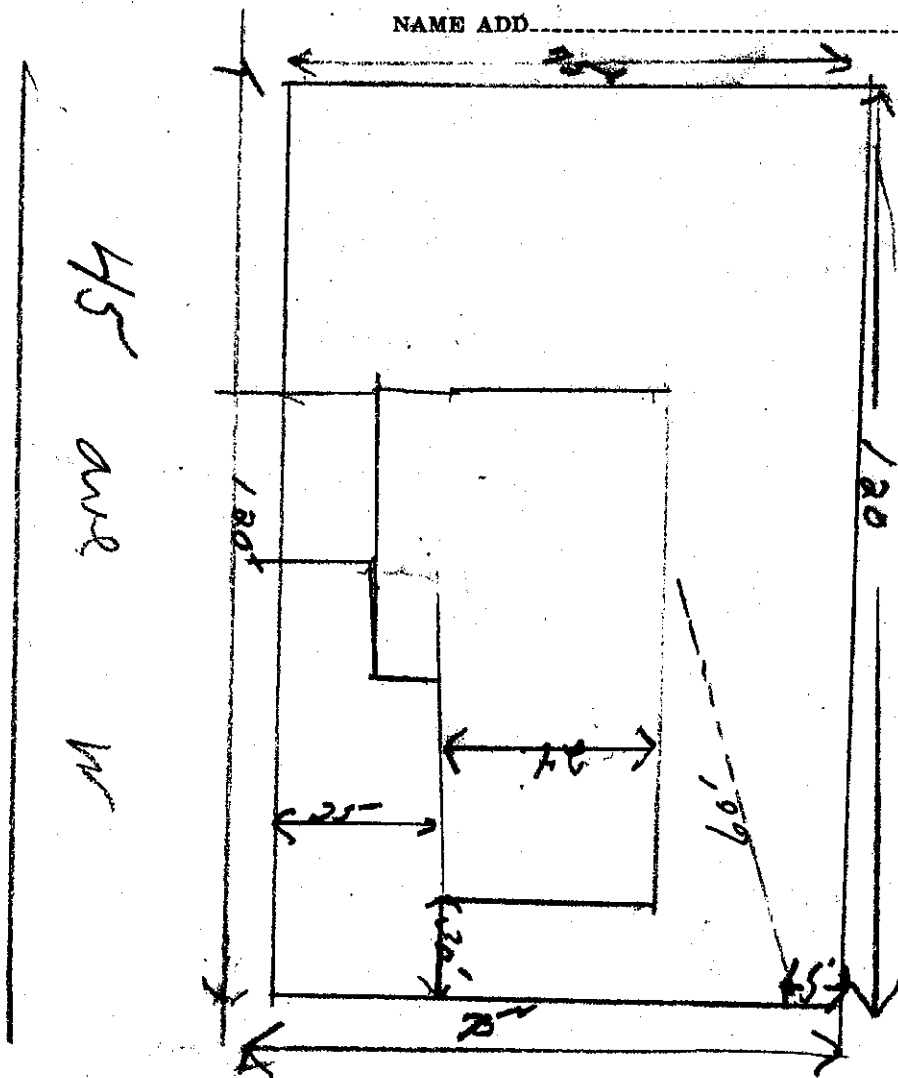

2193
Bldg. Per

BACKFILL WORK ORDER ISSUED _____ DEPOSIT, \$ _____
SEWER WORK ORDER ISSUED _____

Approved: _____
DATE 5/25/62 BY [Signature]