

1 4" concrete x pl ~~SP~~ Strongback


2 SDR 4" pipe

3 4" concrete x pl Strongback

4 15' Liner to 6" pipe

↑  
N

4505

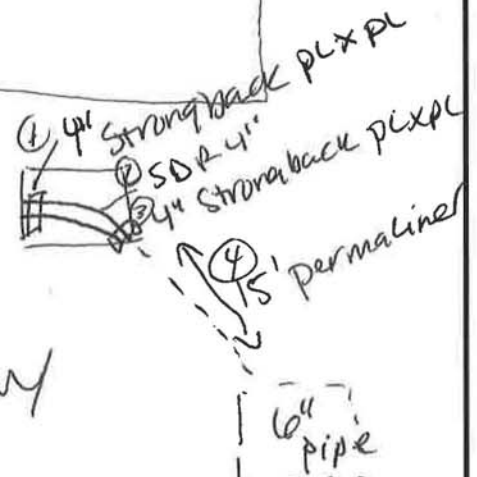

233RD ST

OWNER: Ken Porter

ADDRESS: 4505 233RD ST SW

DATE: 12/27/19

PERMIT #: V-19-0070

Inspector's Signature: *Tom A. Mahan*

## SIDE SEWER DRAWING

1. Drawing must be clearly labeled (streets, north arrow).
2. Indicate location of all piping, cleanouts, manholes or other fixed features.
3. Dimension pipe length and distance from other features.
4. Label diameter, bends, material type of pipe and depth at cleanouts.



CALL BEFORE YOU  
DIG:  
1-800-424-5555 (or 811)