

# APPLICATION

FOR

## SIDE SEWER PERMIT

OUTSIDE ☐ INSIDE ☐ REPAIRS ☐

CARD No. \_\_\_\_\_

EASEMENT No. \_\_\_\_\_

The City of Mountlake Terrace


OWNER NORTHWEST ESCROW

CONTRACTOR LYNNWOOD SEPTIC 74-1 PERMIT No. 74-17

HOUSE No. 3701 224TH PLACE

STREET  
AVENUE LOT No. \_\_\_\_\_ BLOCK No. \_\_\_\_\_

NAME ADD \_\_\_\_\_

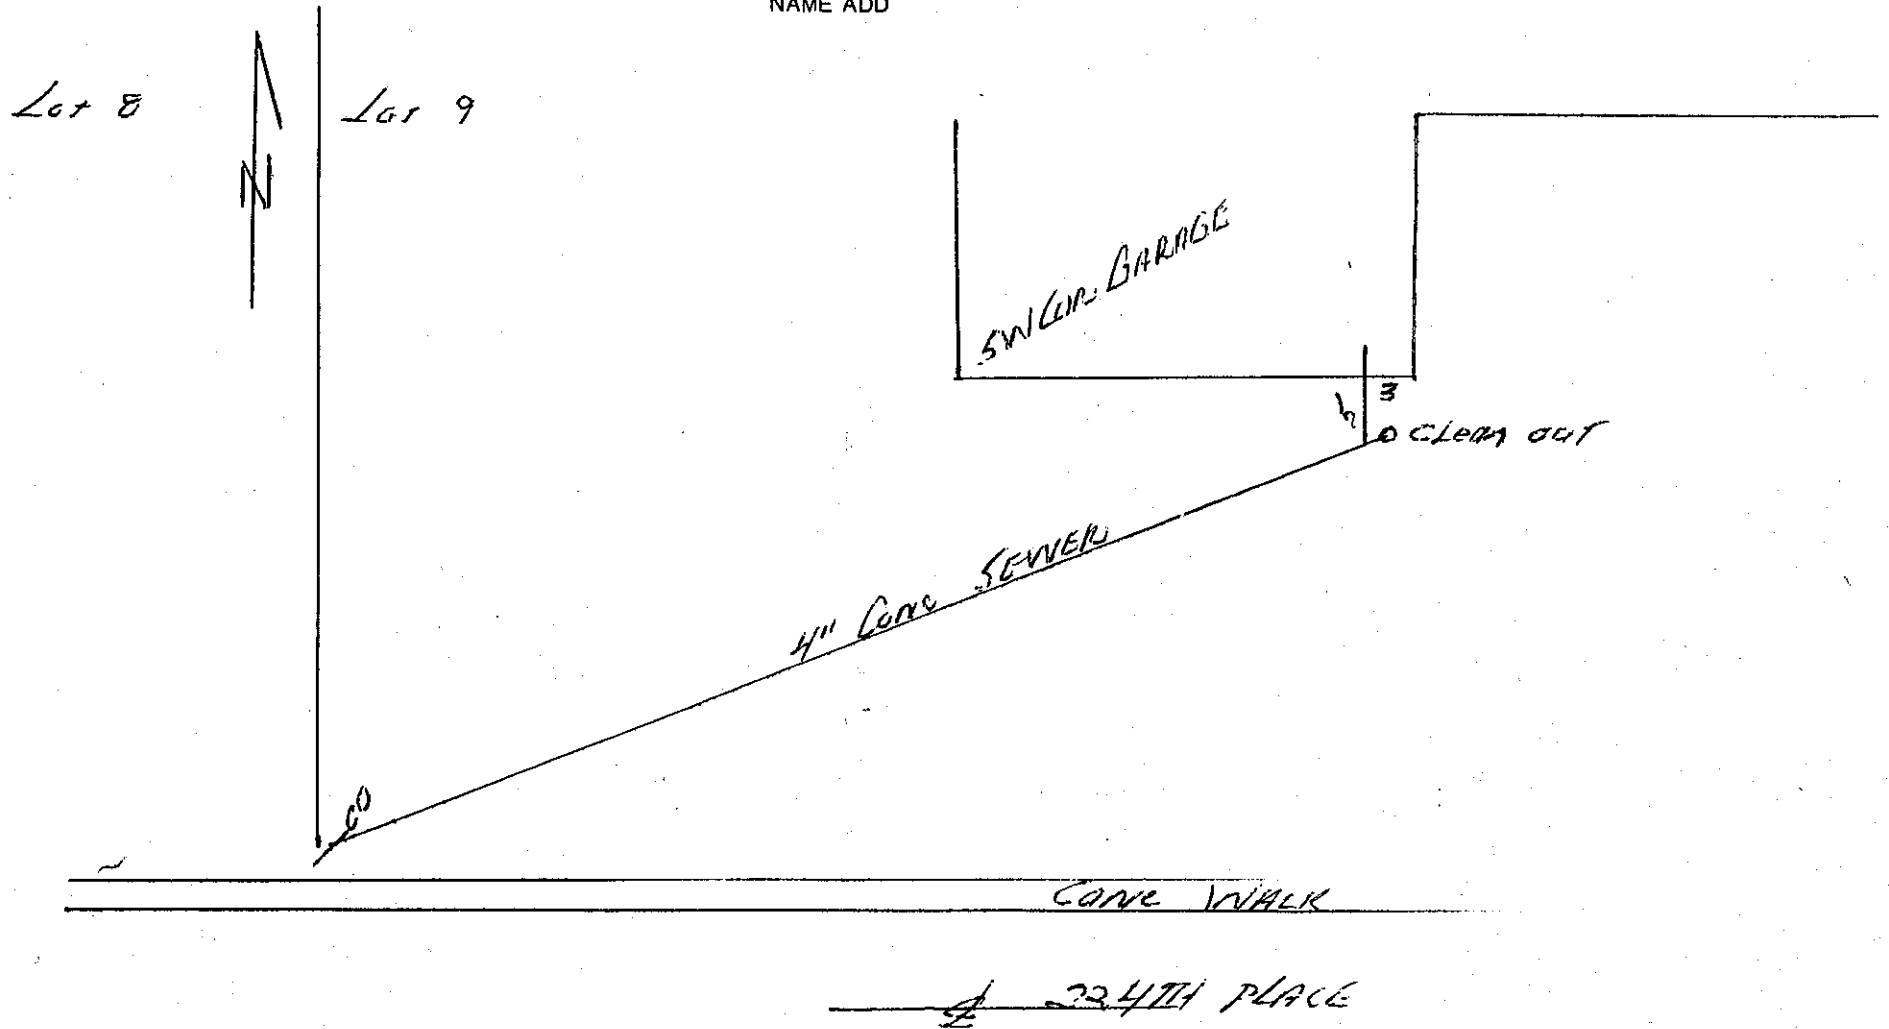

BACKFILL WORK ORDER ISSUED 5-3-74 DEPOSIT, \$ 500 DATE 5-3-74 BY Paul N. Smith

SEWER WORK ORDER ISSUED 5-3-74