

The City of Mountlake Terrace

APPLICATION

for

SIDE SEWER PERMIT

OUTSIDE ☐ INSIDE ☐ REPAIRS ☐

CARD No.

EASEMENT No.

OWNER NORTHWEST ESCROW

CONTRACTOR LYNNWOOD SEPTIC 74-1

PERMIT No. 74-17

HOUSE No. 3703


STREET 224TH PL

LOT No. 1054

NAME ADD

3703

3701

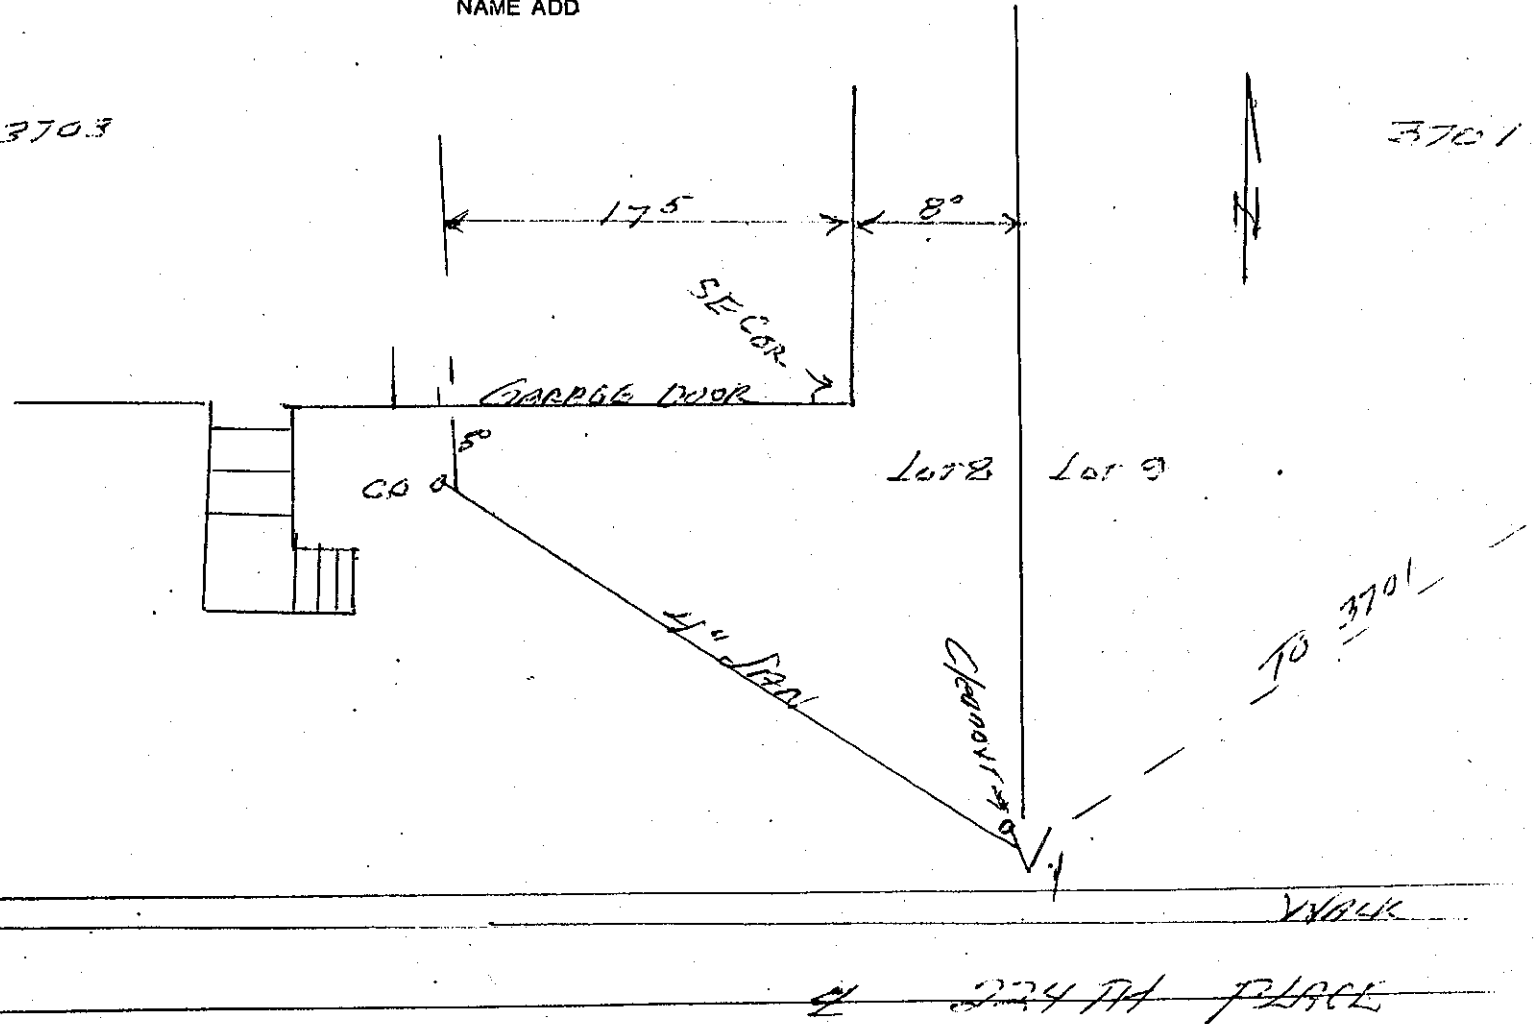

BACKFILL WORK ORDER ISSUED 5-2-74 DEPOSIT, \$ 500
SEWER WORK ORDER ISSUED 5-2-74

Approved: [Signature]
DATE 12/7 BY [Signature]