

APPLICATION

The City of Mountlake Terrace

SIDE SEWER PERMIT

CARD No. _____


OUTSIDE ☐ INSIDE ☐ REPAIRS ☐

EASEMENT No. _____

OWNER Parkwood Homes Inc. CONTRACTOR Lynnwood Septic tank co. PERMIT No. 3923

HOUSE No. 4405 219th STREET 3 AVENUE LOT No. 3 BLOCK No. Tract 39

NAME ADD. Cedar Park

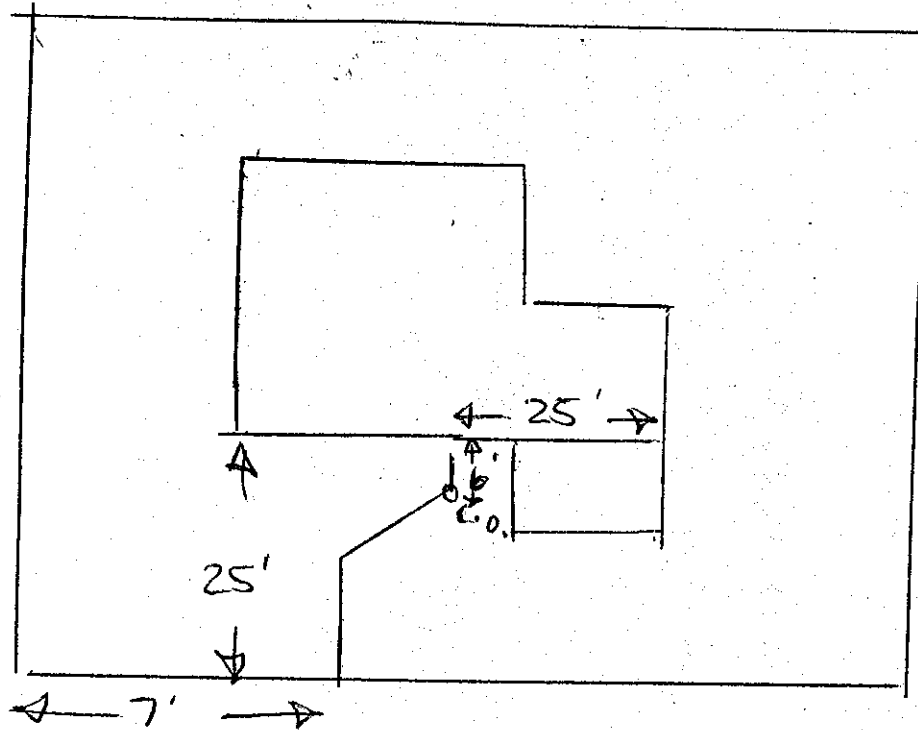

Date _____

Approved: _____

BACKFILL WORK ORDER ISSUED _____ DEPOSIT, \$ _____

SEWER WORK ORDER ISSUED _____

DATE 4-8-65 BY R. Bahr