


WEBER THOMPSON

225 Terry Ave N, Suite 200
Seattle WA 98109
p 206 344 5700
f 206 749 5005

www.weberthompson.com

k p f f Consulting Engineers
1601 Fifth Avenue, Suite 1600
Seattle, Washington 98101-3685
(206) 622-3522 Fax (206) 622-8116

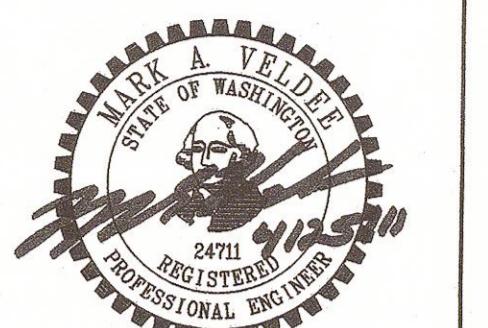

PROJECT:
MOUNTLAKE TERRACE
ARBOR VILLAGE

CLIENT:
AFCO & SONS, LLC

23609 56TH AVE W, SUITE 100
MOUNTLAKE TERRACE, WA 98043

ISSUE:
PRELIMINARY ISSUE 06-11-2010
50% DD SET 9-10-2010
100% DD SET 10-5-2010
30% CD SET 10-13-2010
CD PROGRESS SET 10-20-2010
CD PROGRESS SET 10-28-2010
CD PROGRESS SET 11-05-2010
60% CD SET 11-19-2010
BID SET 12-22-2010
VIEW REVIEW SET 2-10-2011
CITY COMMENTS 4-26-2011

CONSTRUCTION REVISION:

Phase: Client Approval: Quality Assurance:
Schematics _____
Design Dev. _____
Permit Doc. _____
Bid Doc. _____
Const. Doc. _____

ACCEPTANCE OF THE ELECTRONIC FILE VERSION OF THIS DRAWING IS IRREVOCABLE AND CONSTITUTES AGREEMENT TO THE TERMS OF THE WEBER THOMPSON ELECTRONIC MEDIA

UTILITY PLAN

DRAFTED BY:
PROJECT MGR.:
PRINCIPAL I.C.:
SHEET NO.:
TAD
JSF
MAV


10-09

C-4.1
PROJECT NO. 10-09

CALL TWO BUSINESS
DAYS BEFORE YOU DIG
1-800-424-5555

NOTES:

- THE CITY OF MOUNTLAKE TERRACE IS DESIGNING A WATER MAIN REPLACEMENT IN 55TH AVENUE WEST CONCURRENT WITH THIS PERMIT BUT UNDER SEPARATE PERMIT. THE CONTRACTOR SHALL COORDINATE WITH THE CITY INSPECTOR REGARDING CONNECTING TO THE REPLACED WATER MAIN IN 55TH AVENUE WEST.
- EXISTING SEWER SERVICES SHALL BE CAPPED AT THE EDGE OF RIGHT-OF-WAY AND ABANDONED IN PLACE.
- EXISTING WATER SERVICES SHALL BE REMOVED AND DISCONNECTED AT THE CORP STOP IN COORDINATION WITH THE CITY INSPECTOR.

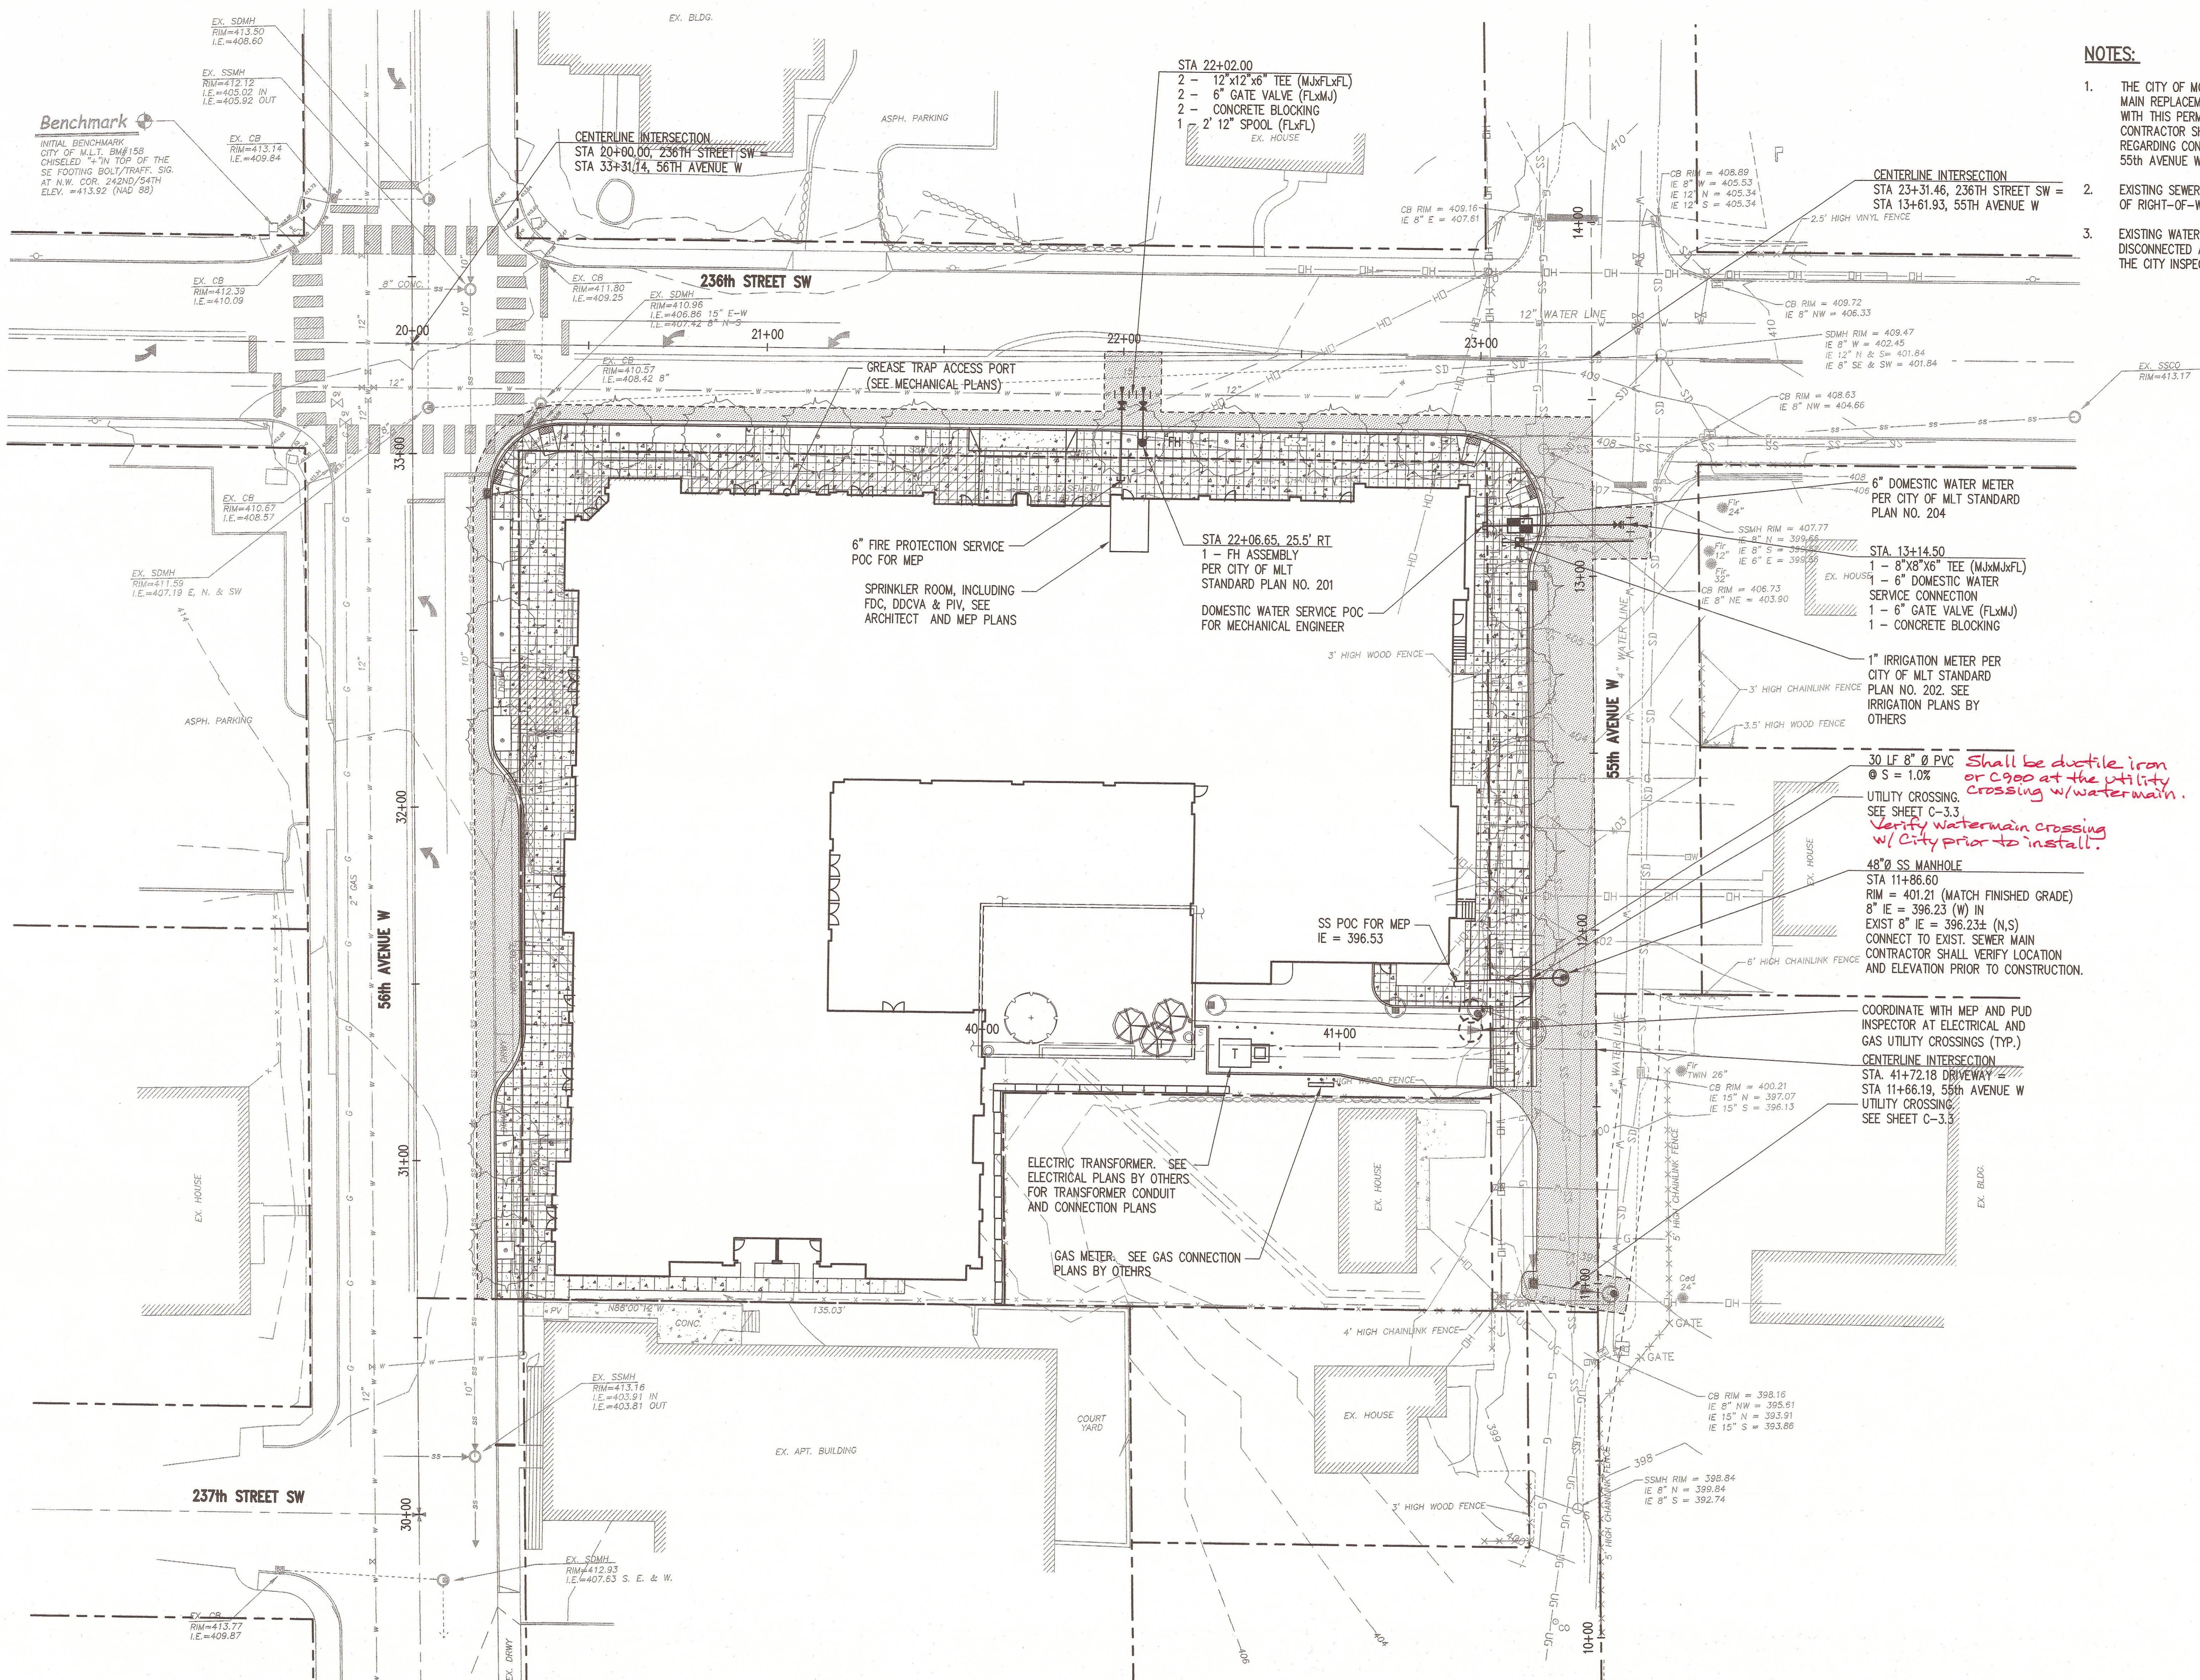

IT SHALL NOT BE CONSTRUED THAT THE PLAN REVIEW WARRANTS OR GUARANTEES THE COMPLETENESS OR CORRECTNESS OF THE DRAWINGS. THE DRAWINGS SUBMITTED AS PERTAINS TO APPLICABLE CODES OR LAWS. ALL REVIEWS ARE SUBJECT TO FIELD INSPECTION AND APPROVAL. ALL CHANGES OR AMENDMENTS SHALL BE SUBMITTED FOR APPROVAL PRIOR TO EXECUTION.

CITY OF MOUNTLAKE TERRACE COMMUNITY
AND ECONOMIC DEVELOPMENT DEPT.
APPROVED FOR CONSTRUCTION
AS NOTED
BY: *Laurie Kinsella* DATE: *6/2/11*

0 10 20 40
1 inch = 20 ft.