


SIDE SEWER AS BUILT

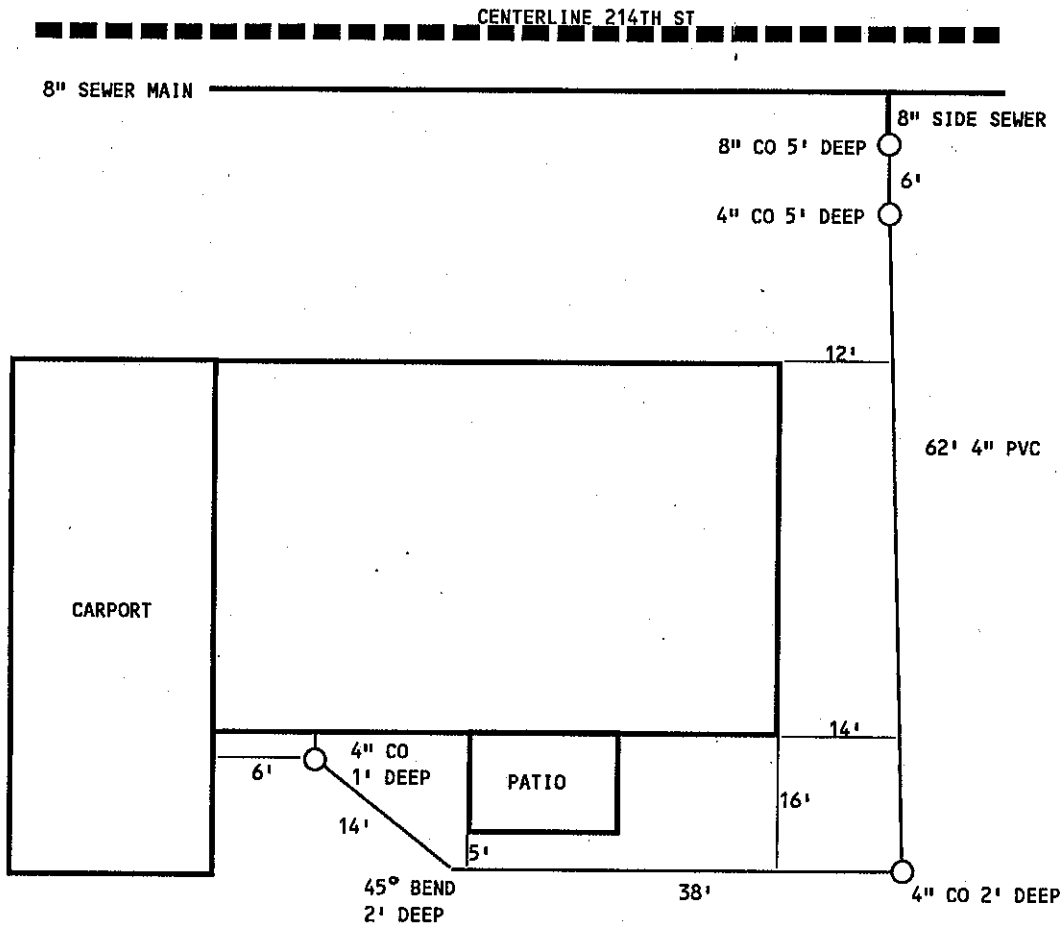

OWNER Maria Rettenbaker

ADDRESS 4216 214th St SW

CONTRACTOR Weber Services

PERMIT NO. U-90-17

RECEIPT NO. 803



WORK ORDER ISSUED 7-25-90

BY B.W.

BACKFILL APPROVED 8-8-90

BY B. Van Deren

AS BUILT 9-10-90

BY D.M.S.