



PLAN	NOTE BOOK	DATE	BY
SHOWN	NOTED	11-1-59	J.H.
PLANNED	NOTED	11-1-59	J.H.
BY	BY	11-1-59	J.H.

PROFILE	NOTE BOOK	DATE	BY
SHOWN	NOTED	11-1-59	J.H.
PLANNED	NOTED	11-1-59	J.H.
BY	BY	11-1-59	J.H.

PROFILE	NOTE BOOK	DATE	BY
SHOWN	NOTED	11-1-59	J.H.
PLANNED	NOTED	11-1-59	J.H.
BY	BY	11-1-59	J.H.

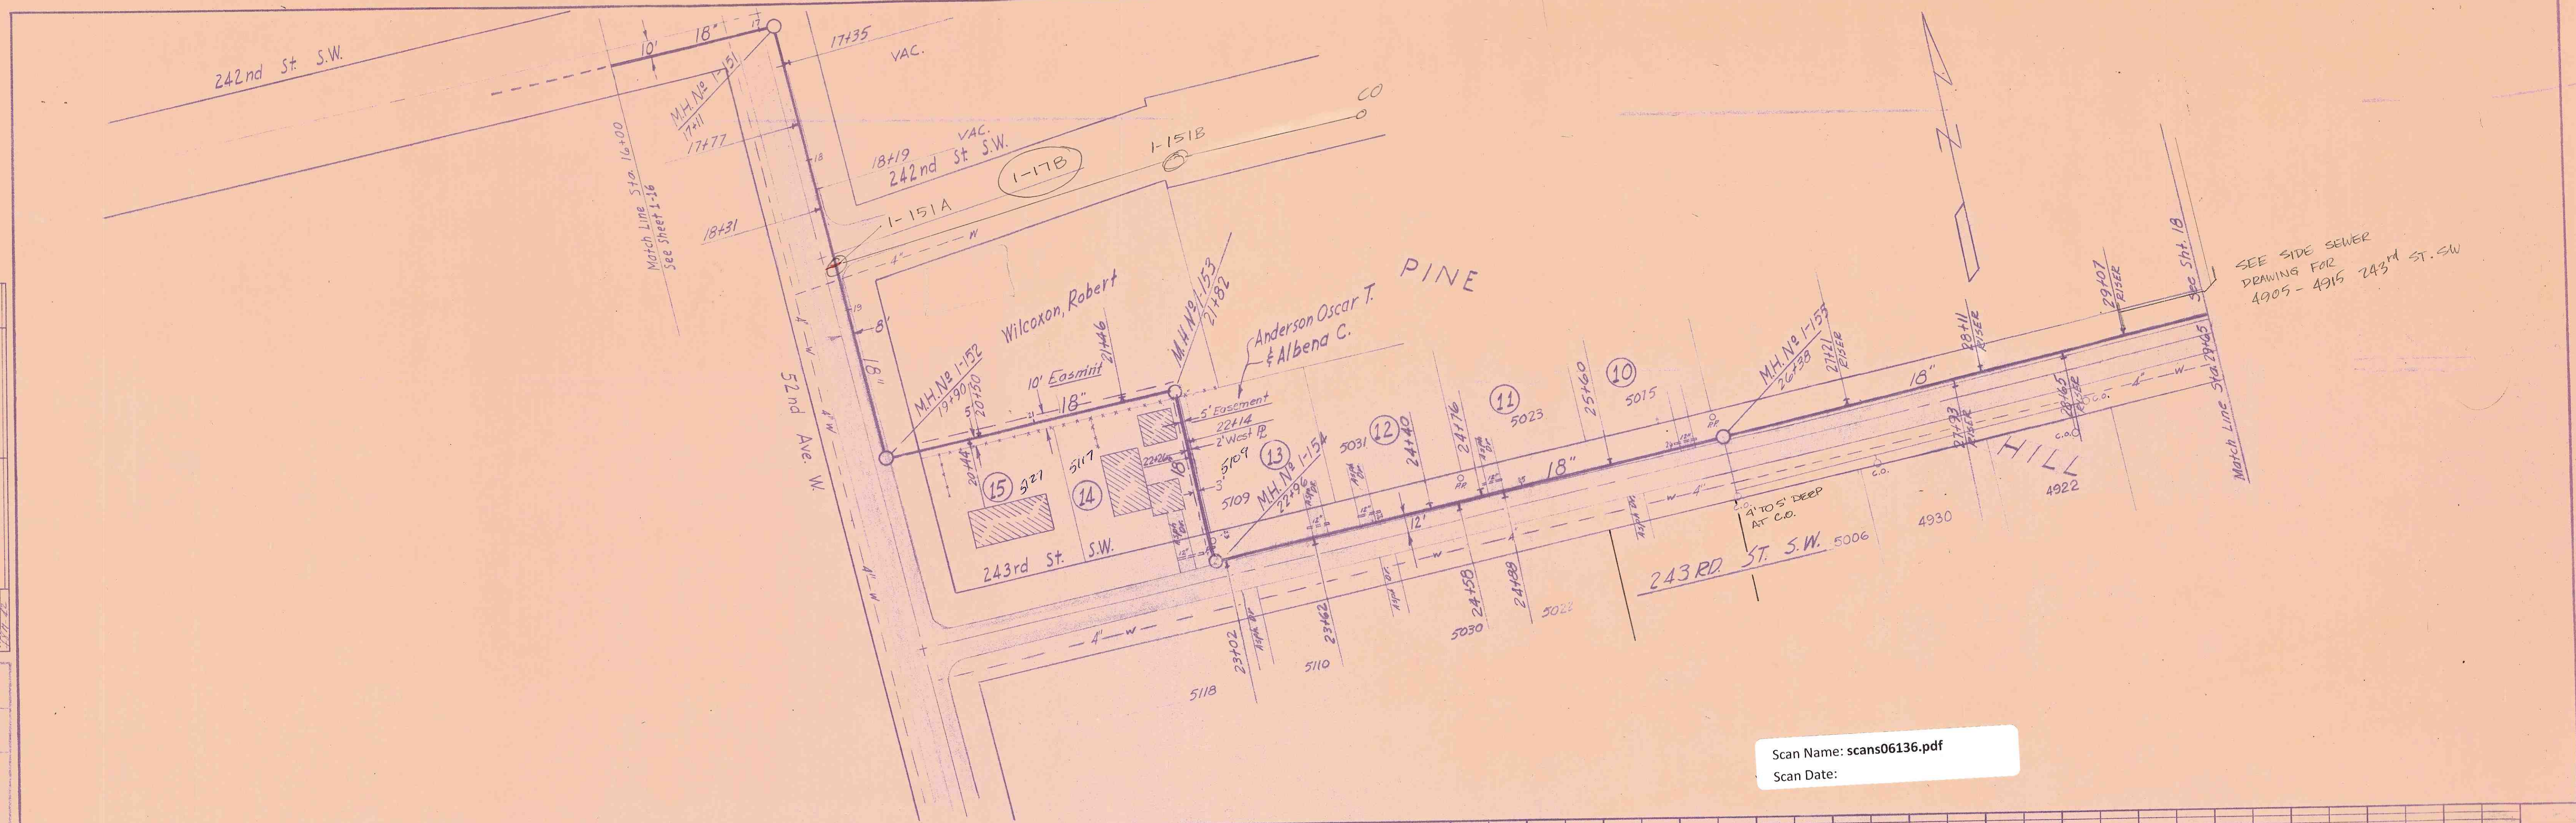

Scan Name: scans06136.pdf  
Scan Date:

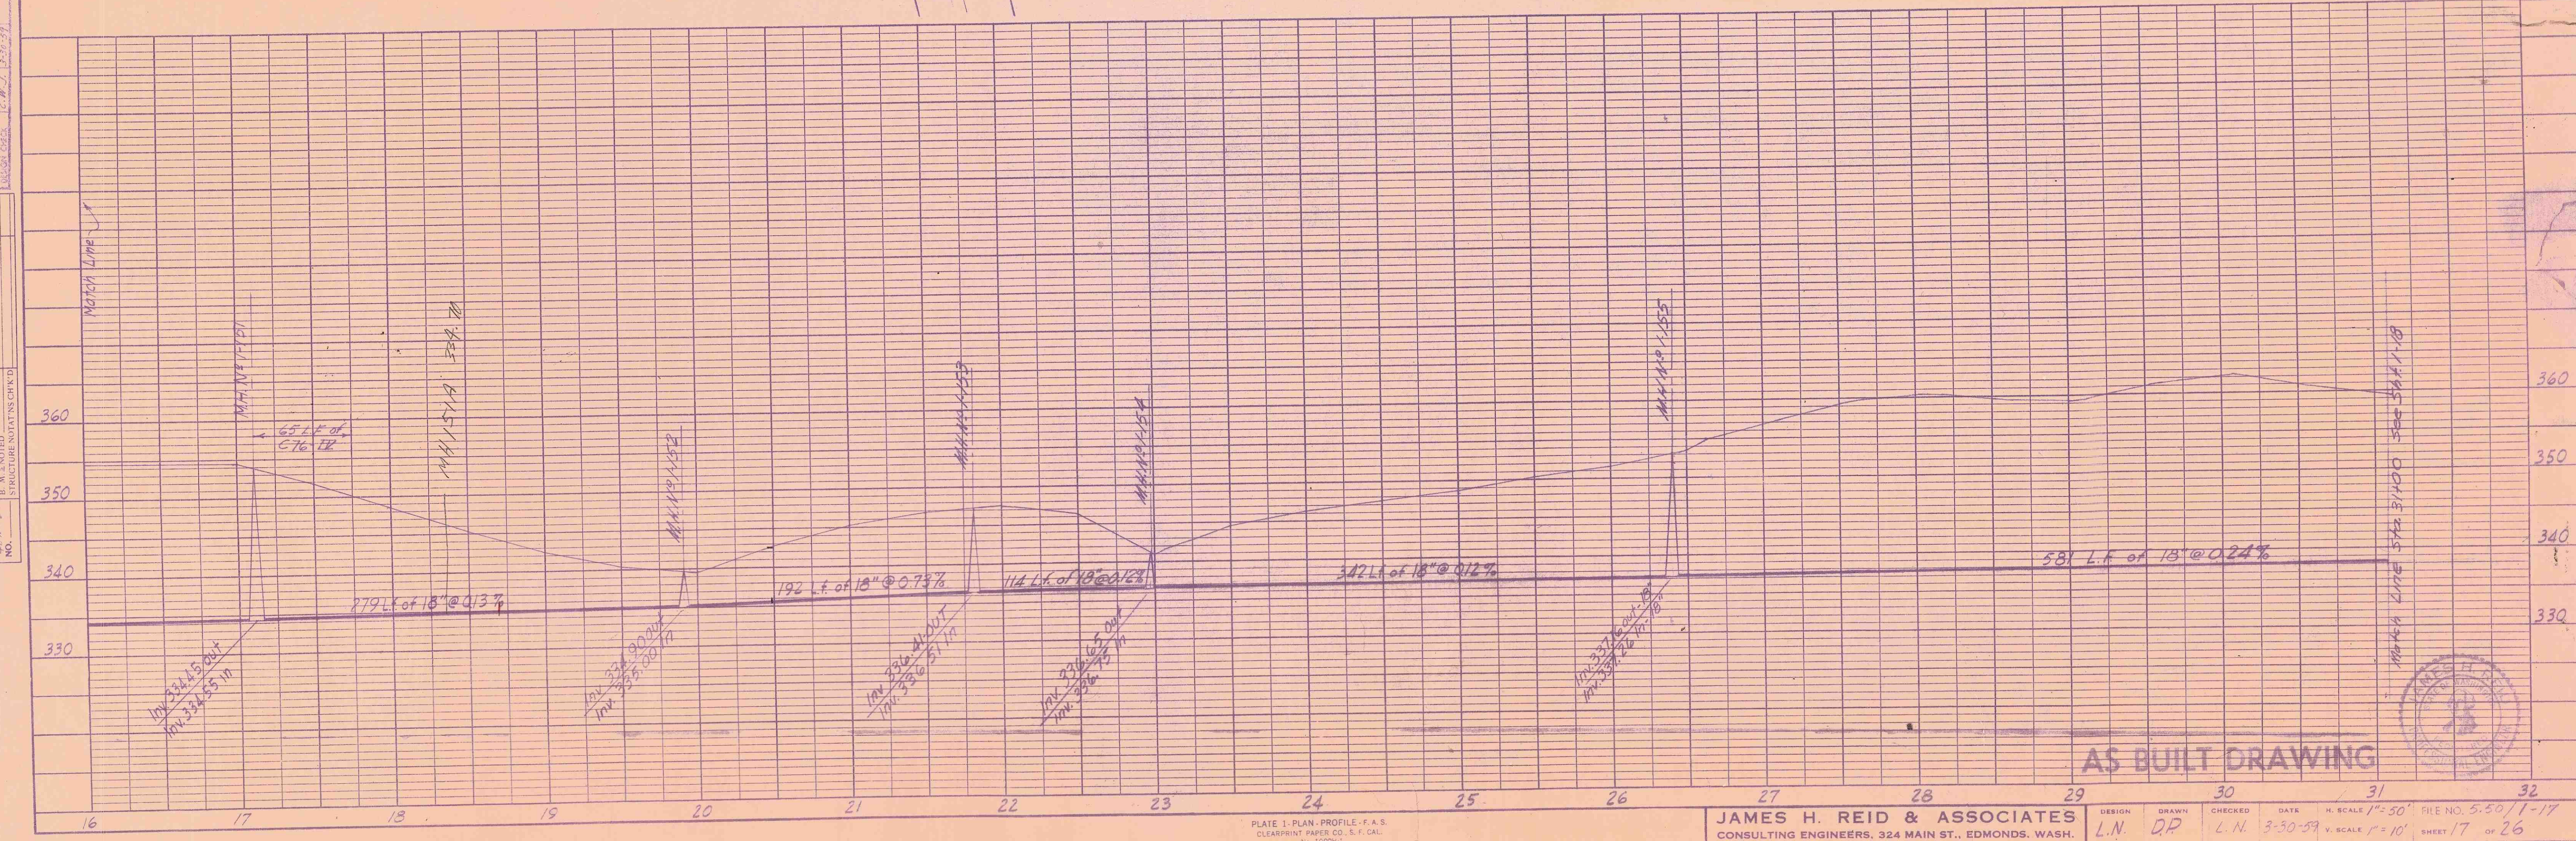

AS BUILT DRAWING