

TIMBERLINE PARK

DEAN ECHELBARGER ~ DEVELOPER

The City of Mountlake Terrace

APPLICATION

for

SIDE SEWER PERMIT

OUTSIDE ☒ INSIDE ☐ REPAIRS ☐

CARD No. \_\_\_\_\_


EASEMENT No. \_\_\_\_\_

OWNER \_\_\_\_\_ CONTRACTOR UNIVERSAL LITL, CONT.

HOUSE No. 22307 36TH AVE W STREET EDMONDS, WASH PERMIT No. 74-14

AVENUE LOT No. 15 BLOCK No. \_\_\_\_\_

NAME ADD \_\_\_\_\_

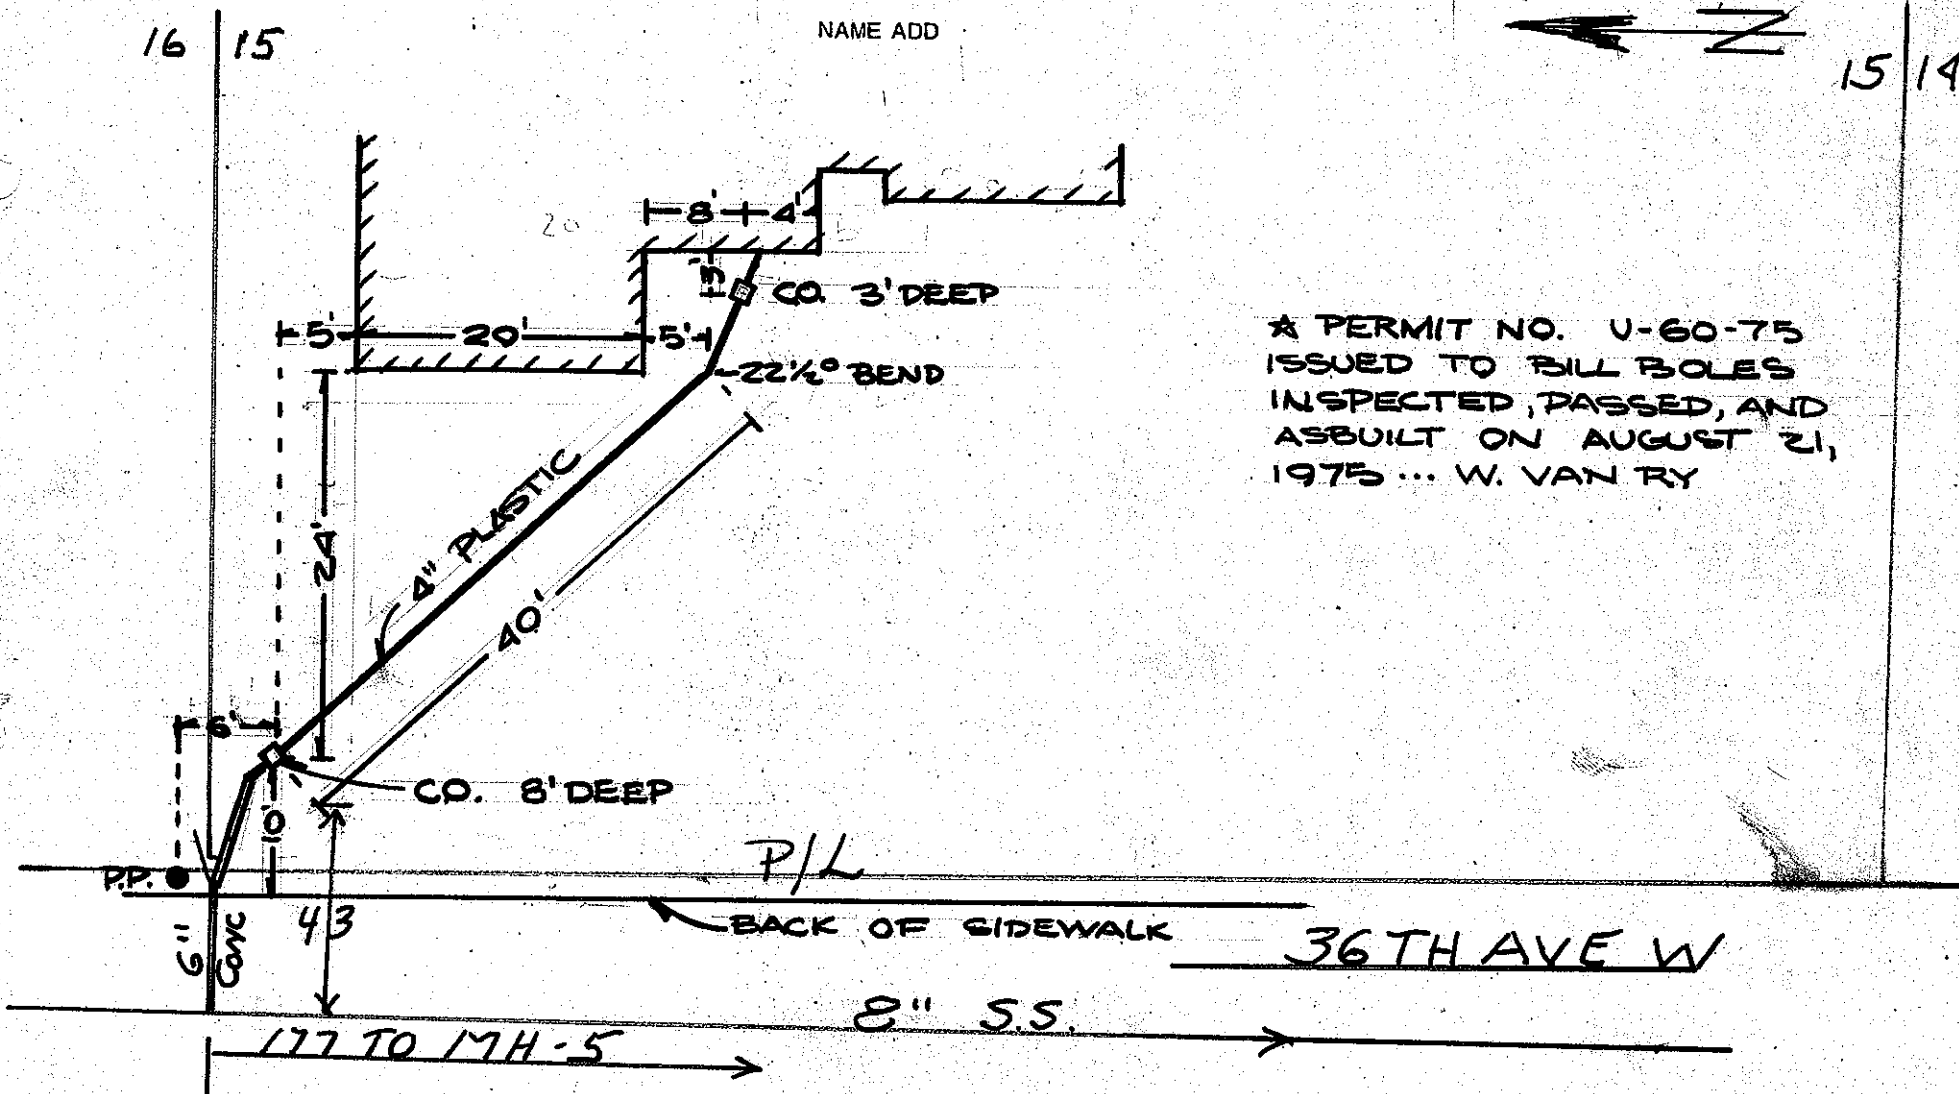

A PERMIT NO. U-60-75  
ISSUED TO BILL BOLES  
INSPECTED, PASSED, AND  
ASBUILT ON AUGUST 21,  
1975 ... W. VAN RY

BACKFILL WORK ORDER ISSUED 7-1-74 DEPOSIT, \$ \_\_\_\_\_

SEWER WORK ORDER ISSUED 4-15-74

MAIN & SERVICE TO P/L

Approved:

DATE 8-74 BY F.H. SMITH 11/10/74