



DATE
BY
CHECKED
APPROVED

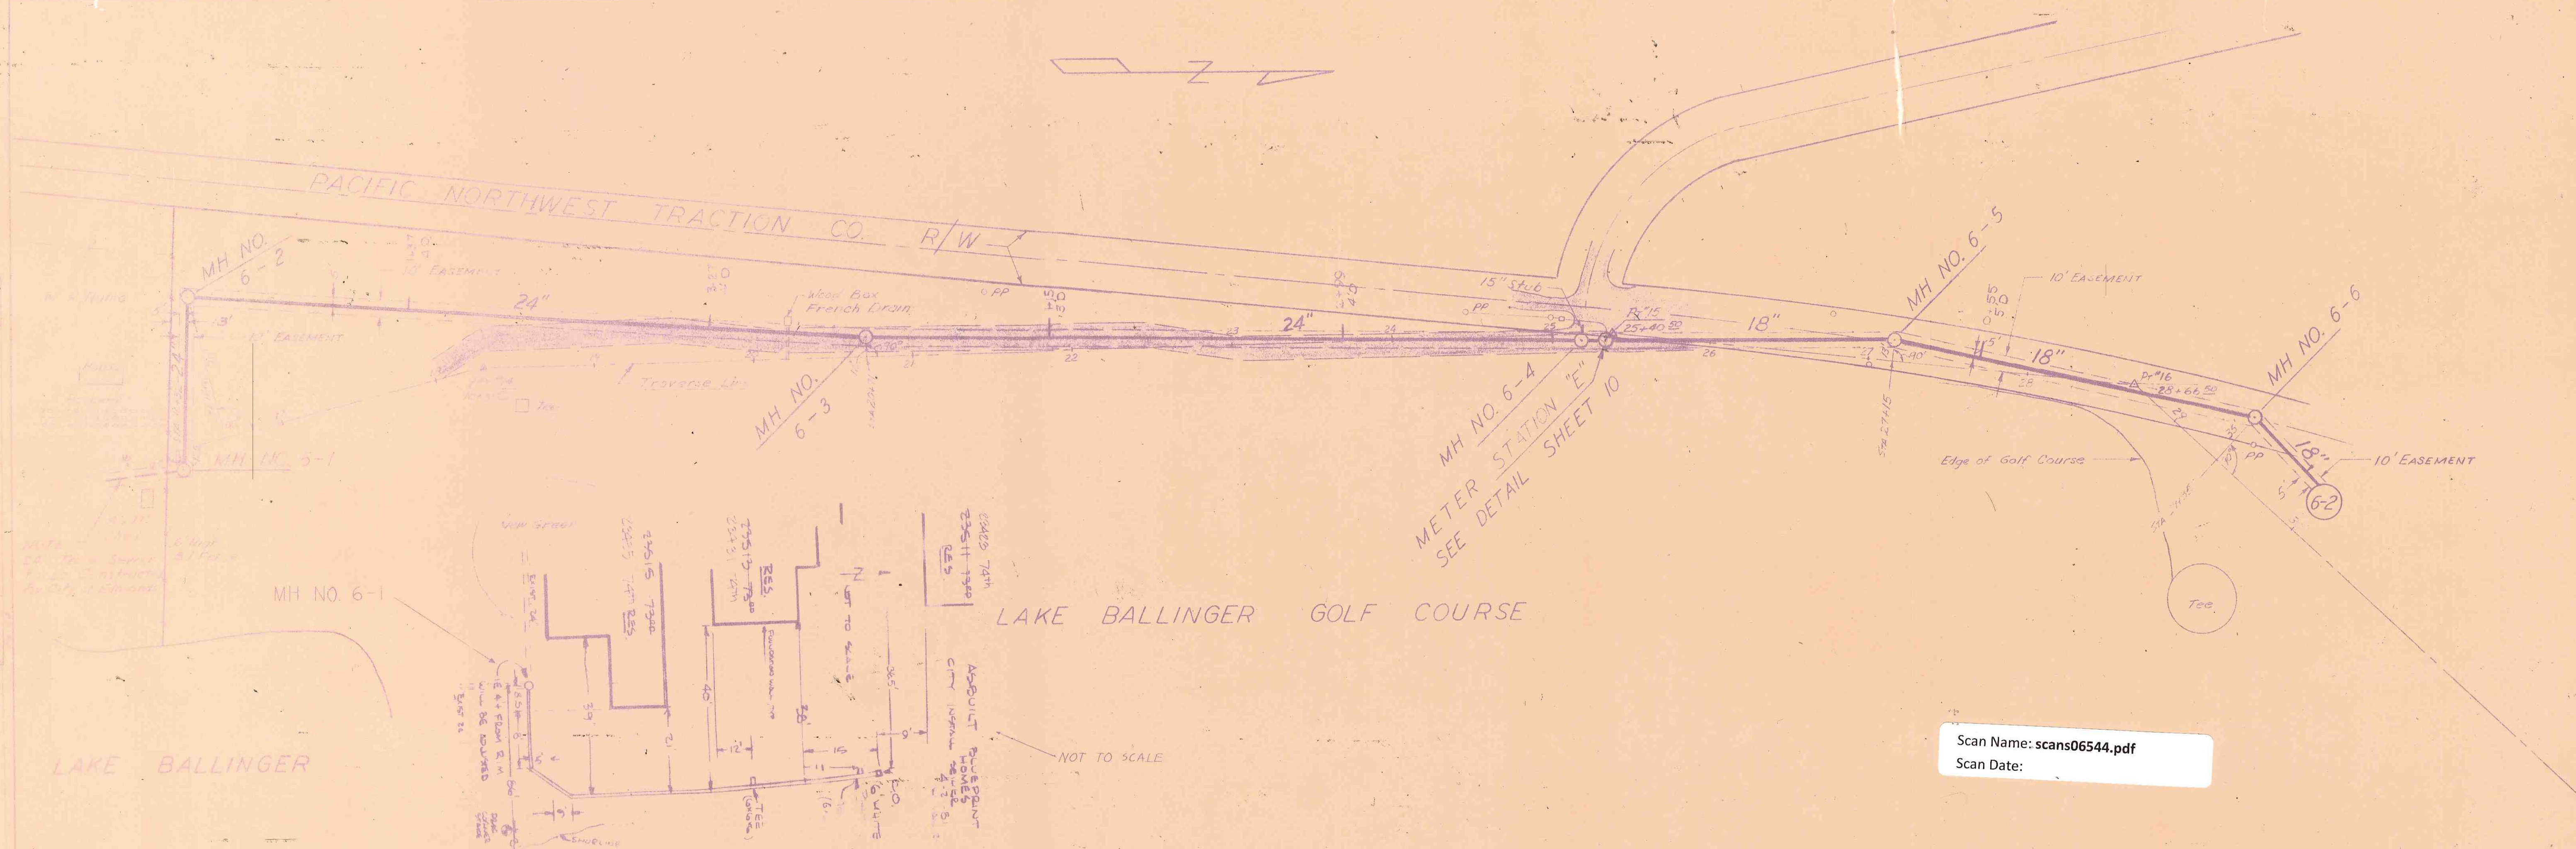

Scan Name: scans06544.pdf
Scan Date:

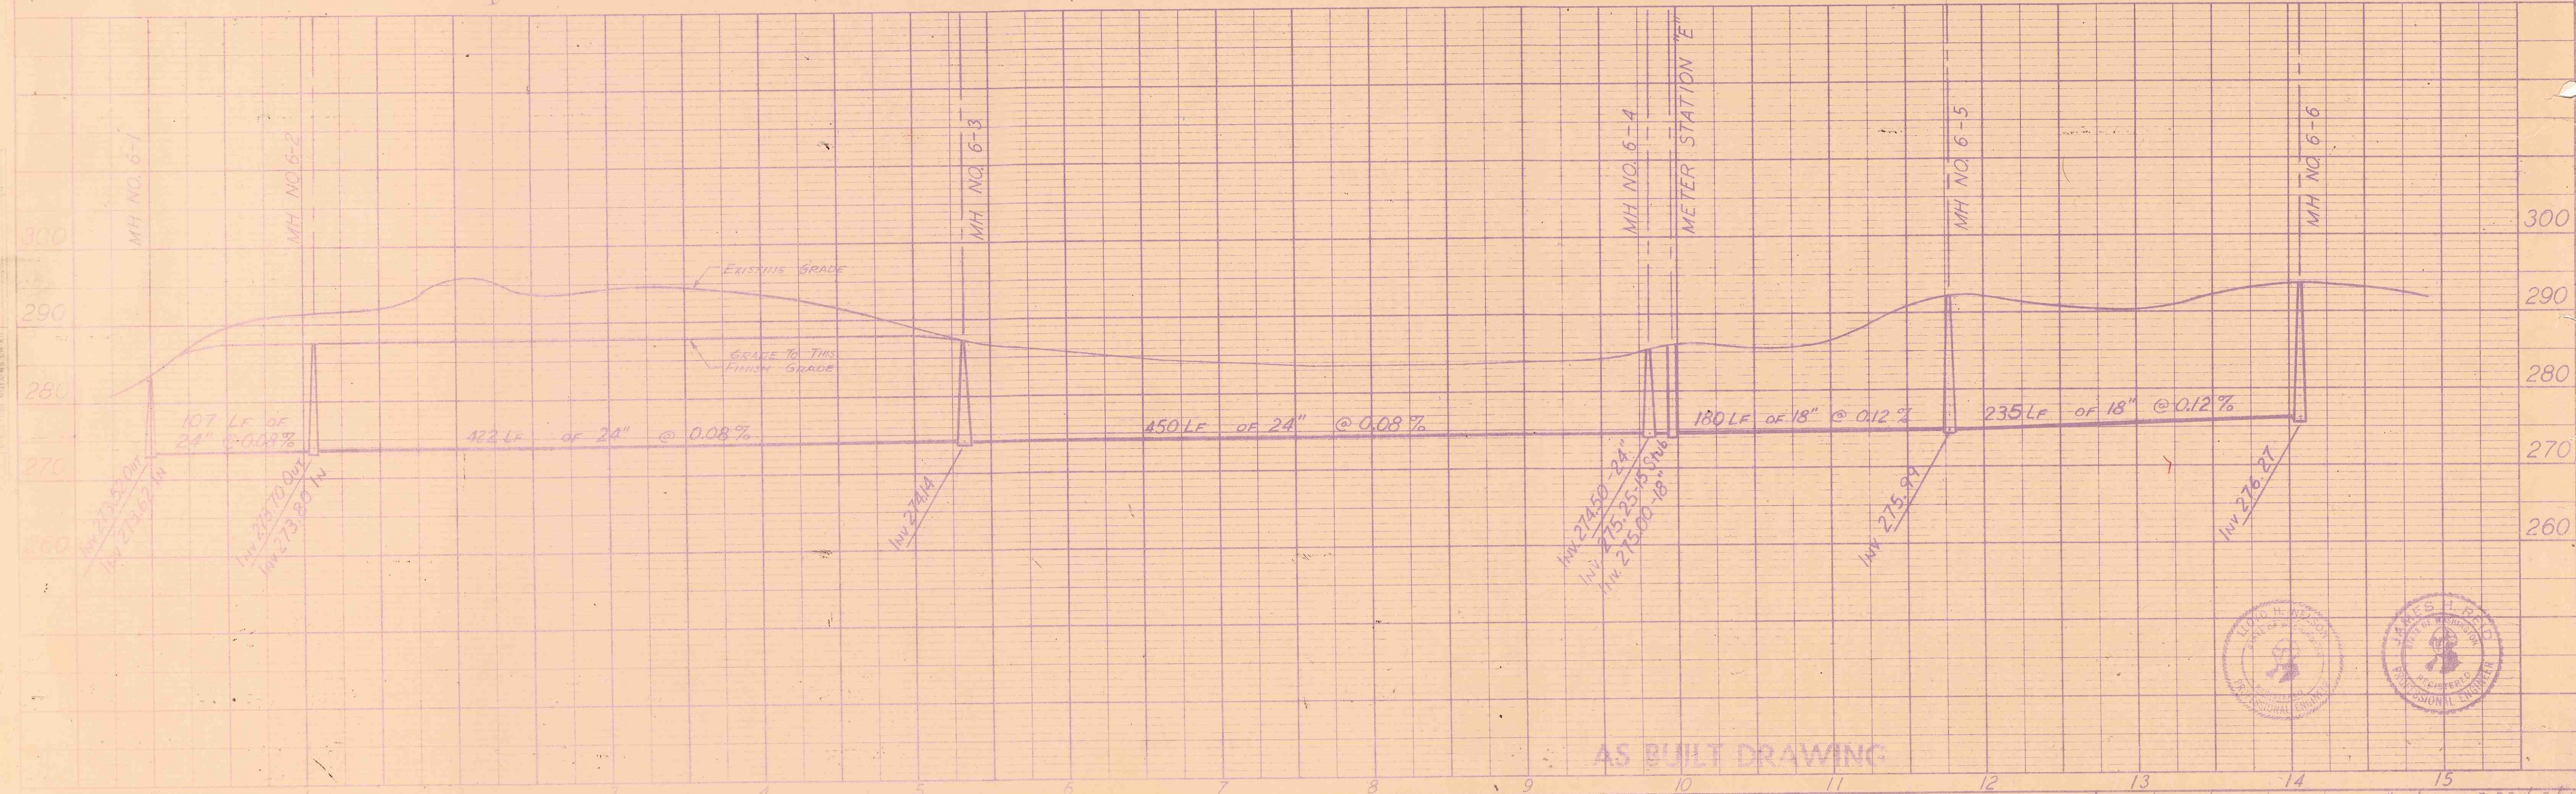

AS BUILT DRAWING