

JIMBERLINE PARK

DEAN ECHELBERGER ~ DEVELOPER

APPLICATION

The City of Mountlake Terrace

SIDE SEWER PERMIT

CARD No. \_\_\_\_\_


OUTSIDE ☒ INSIDE ☐ REPAIRS ☐

EASEMENT No. \_\_\_\_\_

OWNER \_\_\_\_\_ CONTRACTOR UNIVERSAL LIT'L CO. INC.

HOUSE No. 22304 STREET 36TH AVE W AVENUE LOT No. 21 PERMIT No. 74-14

BLOCK No. \_\_\_\_\_

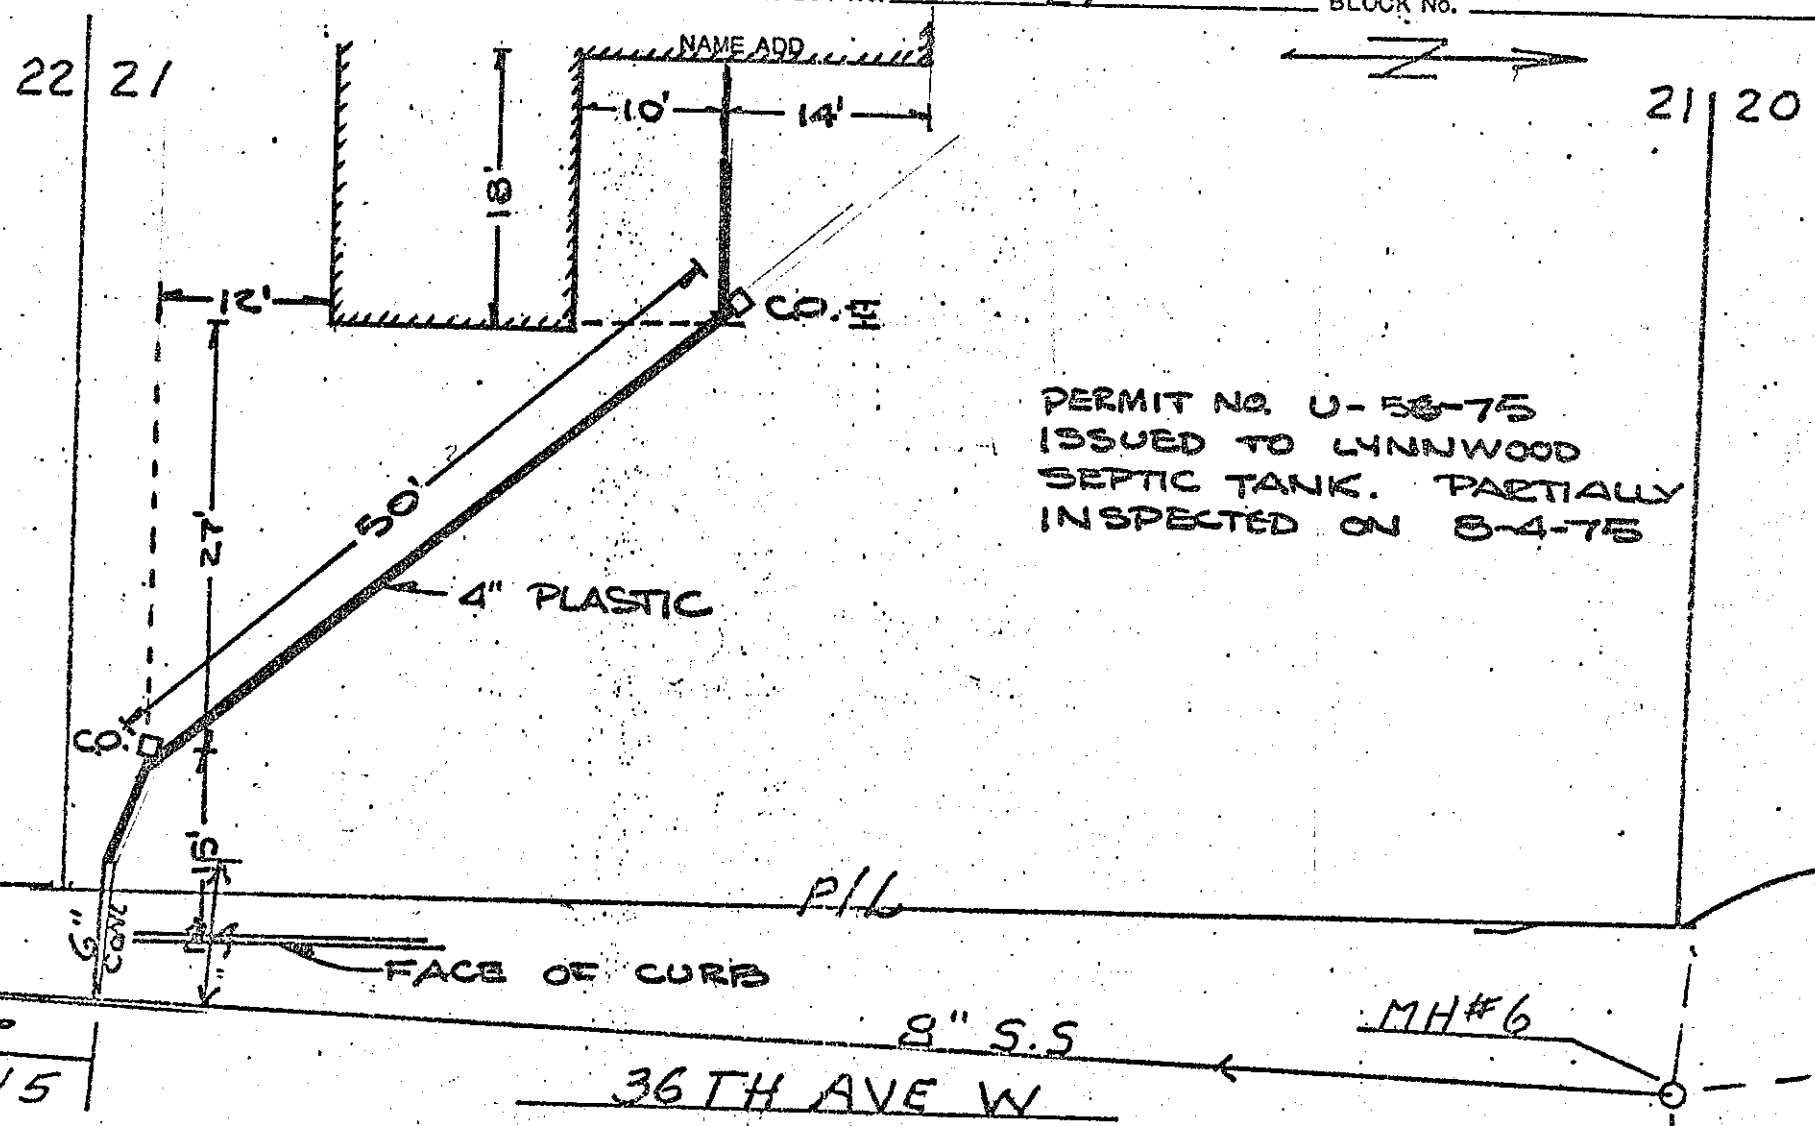

PERMIT NO. U-58-75  
ISSUED TO LYNNWOOD  
SEPTIC TANK. PARTIALLY  
INSPECTED ON 8-4-75

BACKFILL WORK ORDER ISSUED 7-1-74 Date 7-1-74 DEPOSIT, \$ \_\_\_\_\_ Approved: \_\_\_\_\_  
ORDER ISSUED 7-15-74 DATE 8-74 BY F.H. SMITH