


PLAN	DATE
BY	
CHECKED	
APPROVED	
NOTED	
REVISIONS	

PROFILE	DATE
BY	
CHECKED	
APPROVED	
NOTED	
REVISIONS	

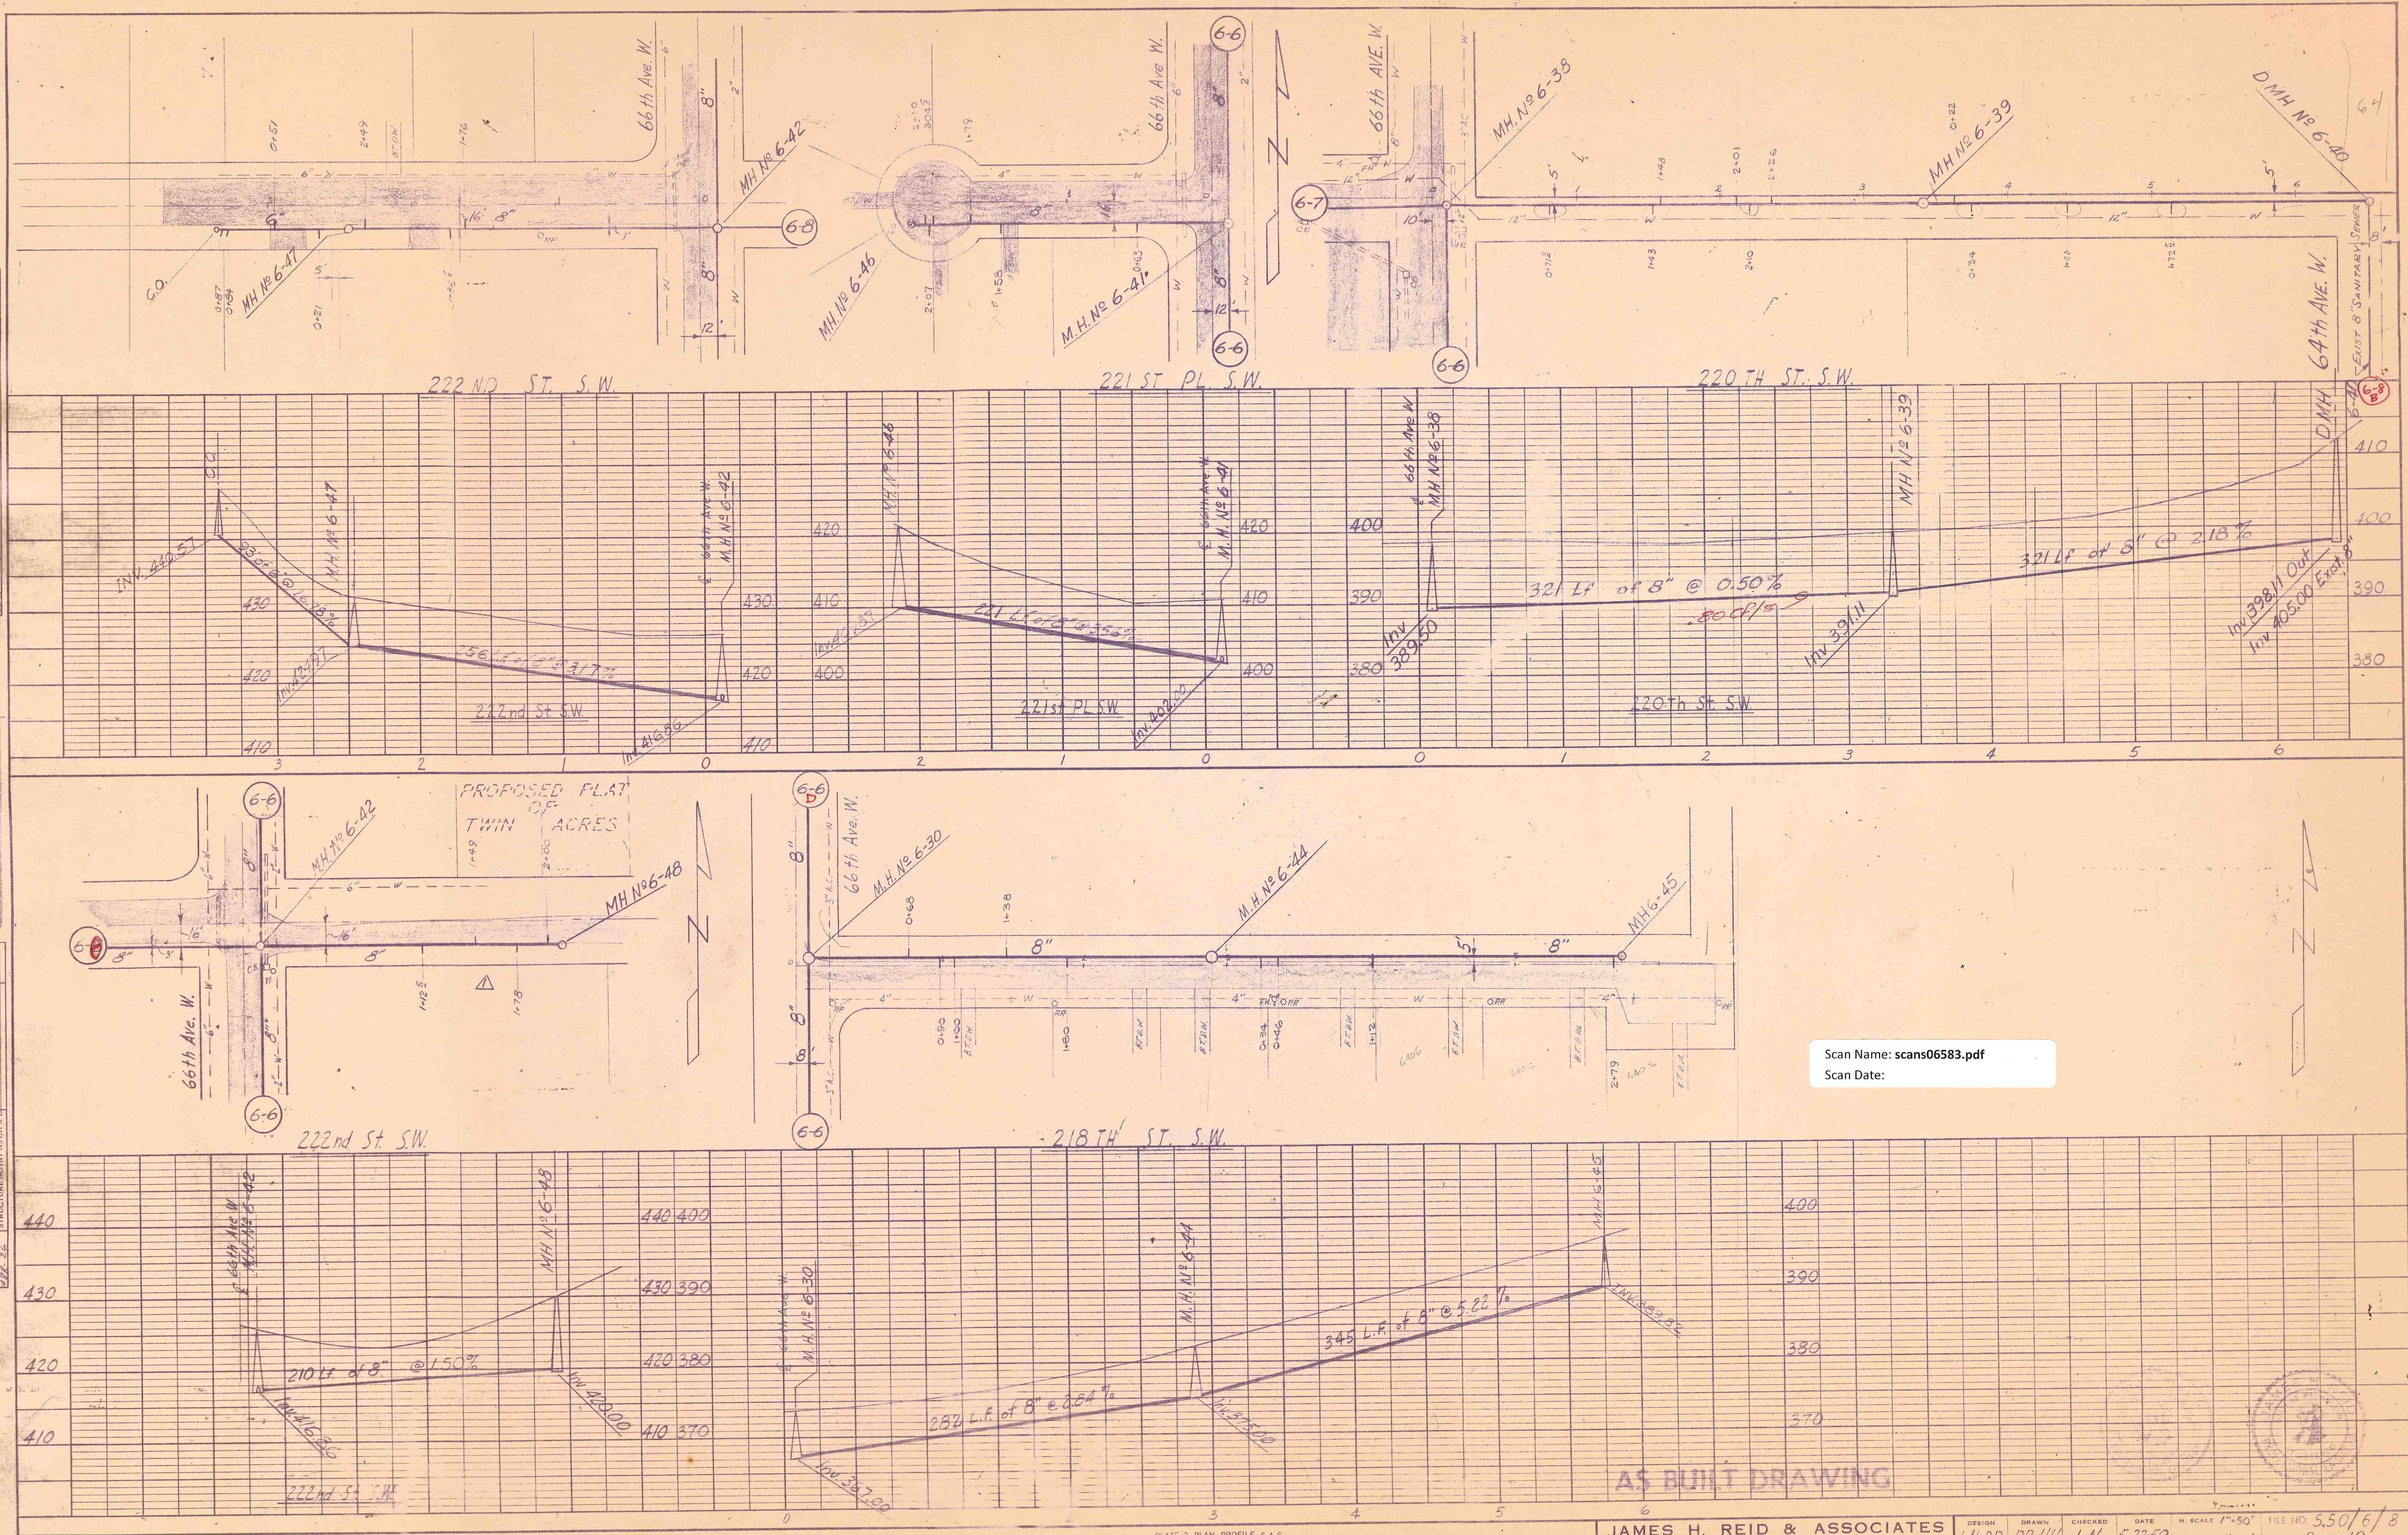

Scan Name: scans06583.pdf
 Scan Date:

AS BUILT DRAWING

PLATE 2 - PLAN - PROFILE - F.A.S.
 CLEARPRINT PAPER CO. S.F. CAL.
 No. 100012

JAMES H. REID & ASSOCIATES
 CONSULTING ENGINEERS, 324 MAIN ST., EDMONDS, WASH.

DESIGN	DRAWN	CHECKED	DATE	H. SCALE	V. SCALE	FILE NO.	SHEET
LN-DR	DR-HH	LN	5-22-59	1"=50'	1"=10'	550/6/8	8 OF 10

CITY OF MOUNTLAKE TERRACE
 SEWERAGE SYSTEM
 UNIT 6