

# APPLI TION

The City of Mountlake Terrace

SIDE SEWER PERMIT

CARD No.


OUTSIDE ☐ INSIDE ☐ REPAIRS ☐

EASEMENT No.

OWNER Parkwood Homes Inc CONTRACTOR Lynwood Septic Tank Co PERMIT No. 3989

HOUSE No. 4505- 219 SW STREET 8 AVENUE LOT No. 8 BLOCK No.

NAME ADD. Parkwood Lane

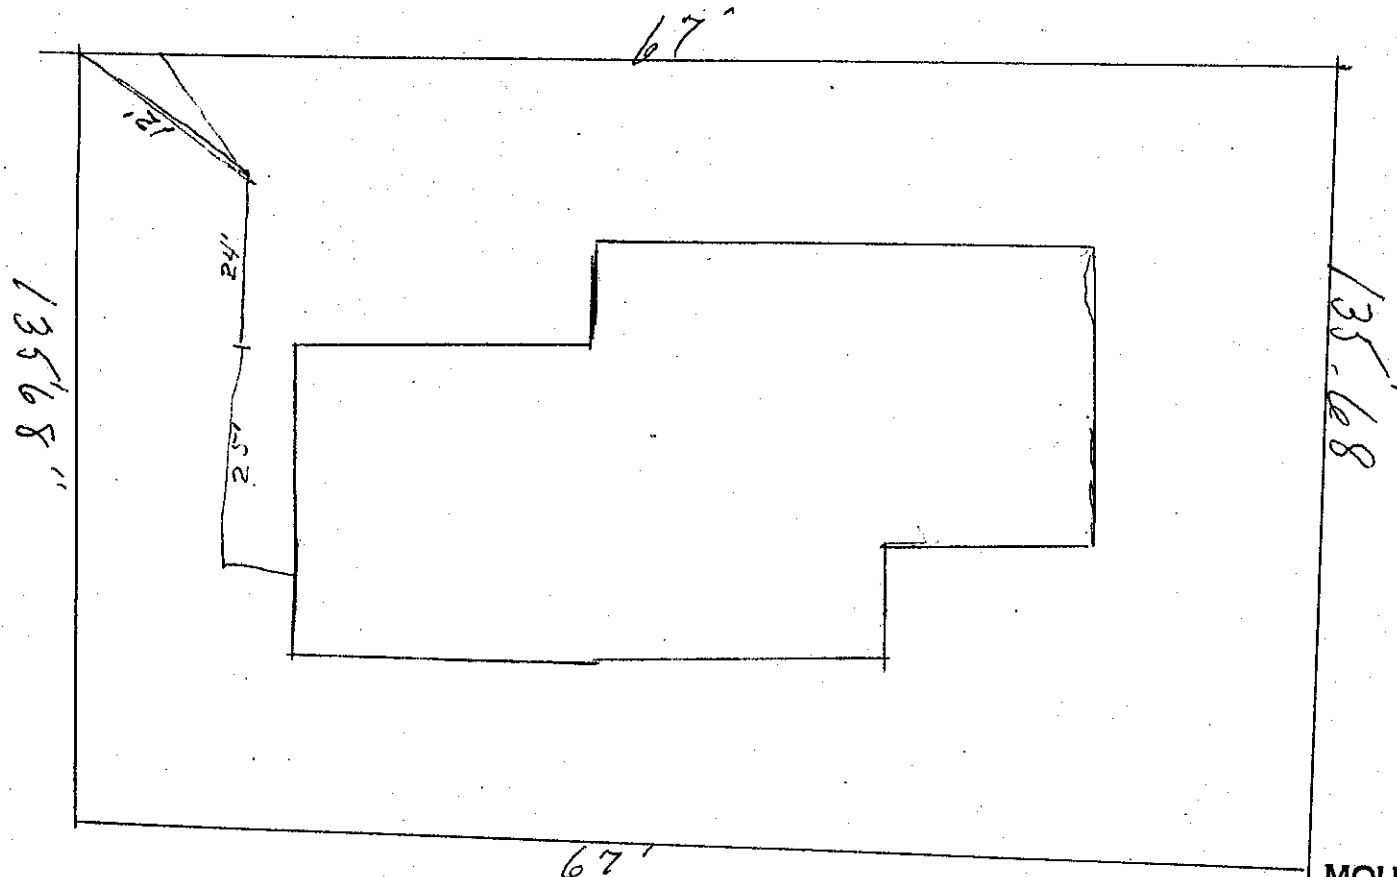

CITY OF  
MOUNTLAKE TERRACE

SEP 13

Date

9/14/65 Rec. 14781

Approved:

Plan Approved

*[Signature]*

BACKFILL WORK ORDER ISSUED DEPOSIT, \$

SEWER WORK ORDER ISSUED

DATE 9/14/65 BY