

The City of Mountlake Terrace

APPLICATION

for

SIDE SEWER PERMIT

OUTSIDE ☒ INSIDE ☐ REPAIRS ☐

CARD No.

BASEMENT No.

OWNER WALTER L. THOMAS

CONTRACTOR OWNER

PERMIT No. 2639


HOUSE No. 23010 63RD PL. W.

STREET
AVENUE LOT No. 62

BLOCK No. D

NAME ADD. DIVISION No. 18

LOT LINE 118.26'

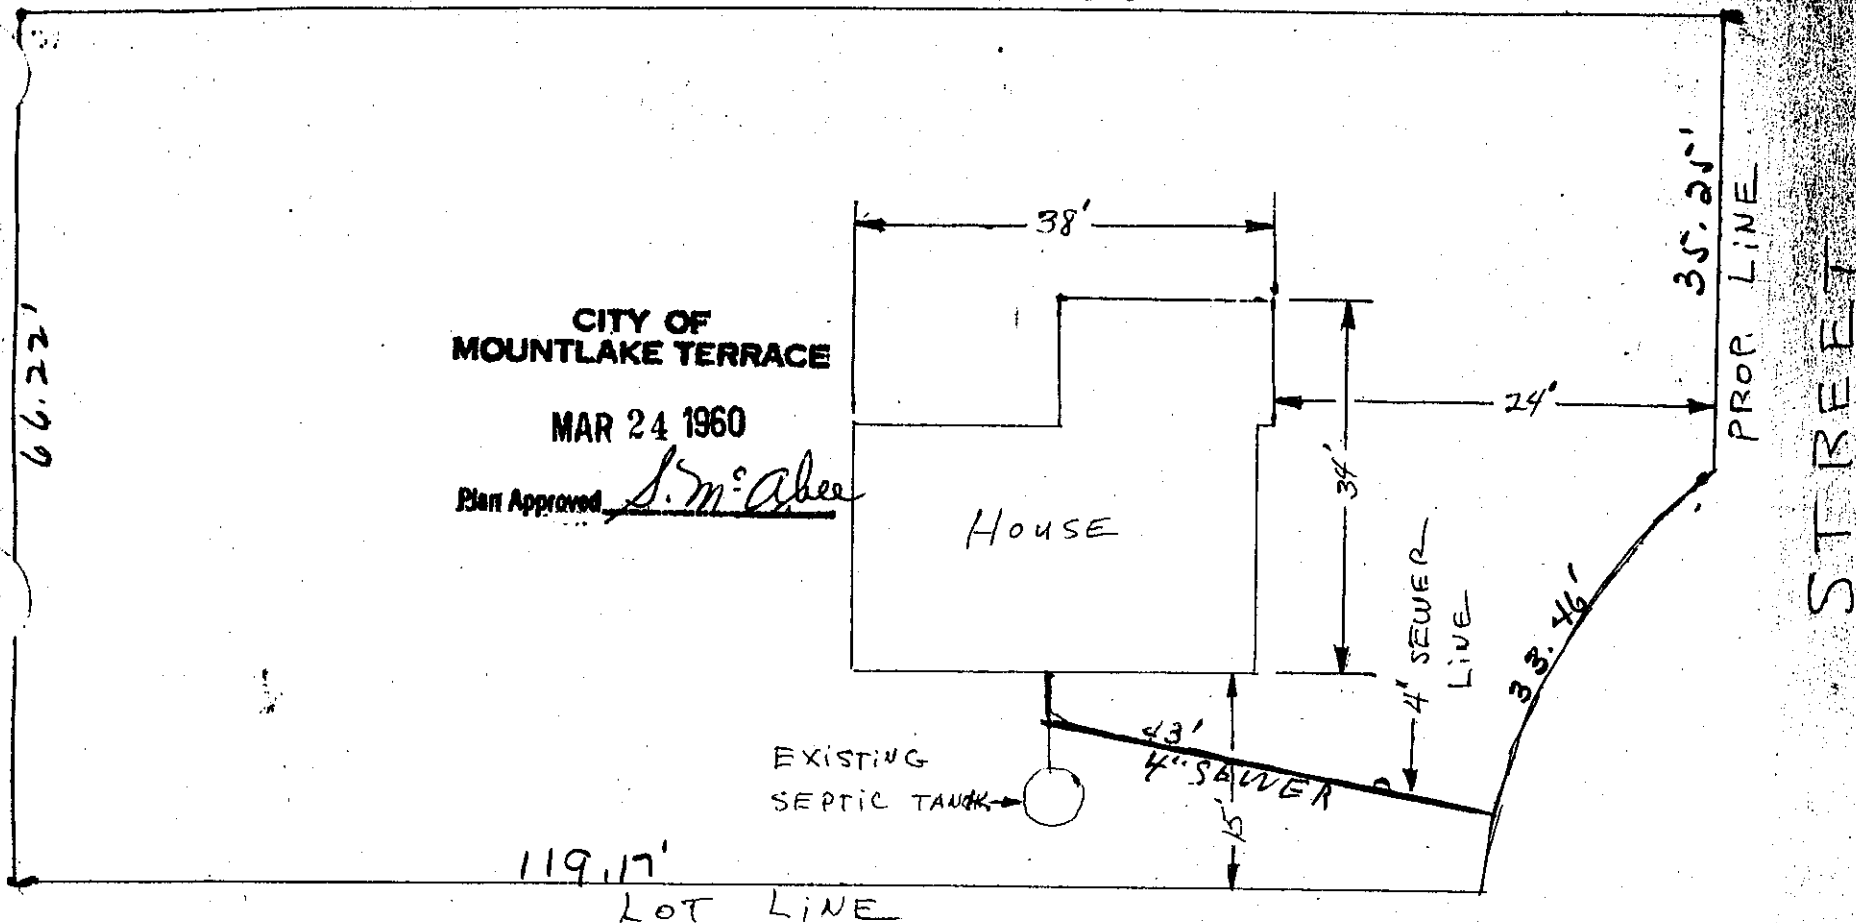

CITY OF
MOUNTLAKE TERRACE

MAR 24 1960

Plan Approved

S. M. Ahee

HOUSE

EXISTING
SEPTIC TANK

43'
4\"/>

4\"/>

33.46'

35.25'
PROP. LINE

STREET

Date

BACKFILL WORK ORDER ISSUED

DEPOSIT, \$10.00

3/17/60

Approved:

SEWER WORK ORDER ISSUED

884

DATE

3-24-60

BY

Scott M. Walton INS & CO.