

# APPLICATION

for

SIDE SEWER PERMIT


CARD No. \_\_\_\_\_

The City of Mountlake Terrace

OUTSIDE ☐ INSIDE ☐ REPAIRS ☐

EASEMENT No. \_\_\_\_\_

OWNER Parkwood Homes Inc CONTRACTOR Lynnwood Septic Tank Co PERMIT No. \_\_\_\_\_  
 HOUSE No. 4701-242 SW STREET E 1st Ave AVENUE LOT No. \_\_\_\_\_ BLOCK No. \_\_\_\_\_  
 NAME ADD. \_\_\_\_\_

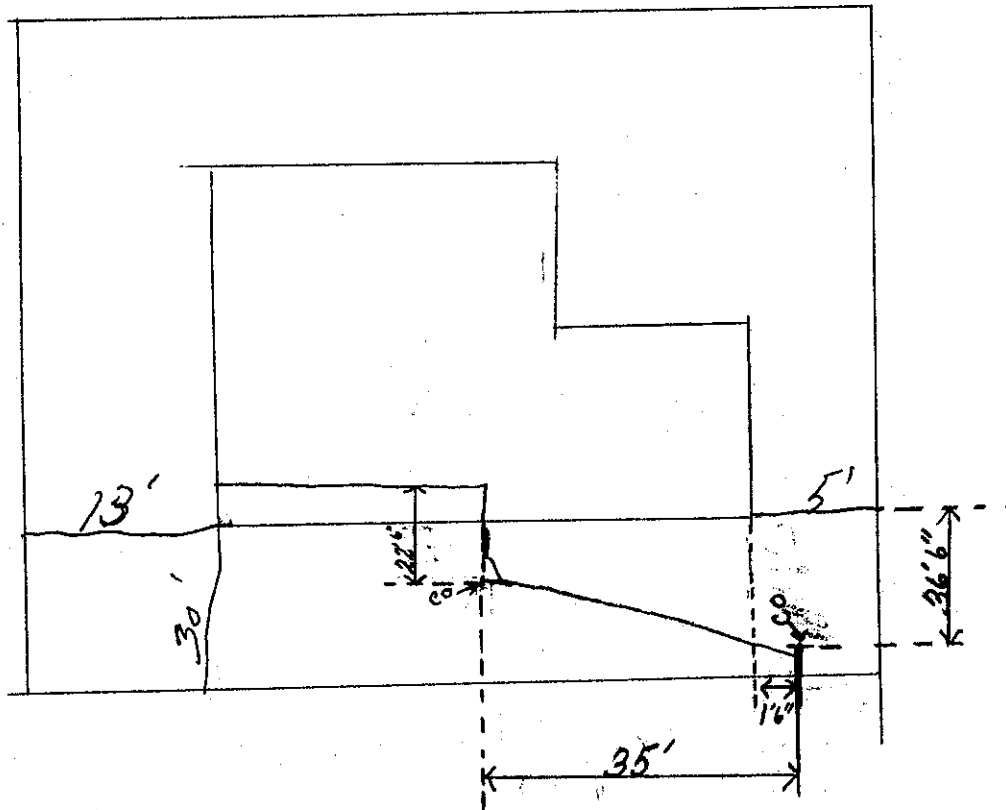

BACKFILL WORK ORDER ISSUED \_\_\_\_\_ Date \_\_\_\_\_ DEPOSIT, \$ \_\_\_\_\_  
 SEWER WORK ORDER ISSUED \_\_\_\_\_

Approved: \_\_\_\_\_  
 DATE 5/16/66 BY Larberg