


40TH AVE. W.

SEWER MAIN

TEST TEE
4X6 REDUCER
8' DEEP

PROPERTY
LINE

21405 40TH AVE. W.

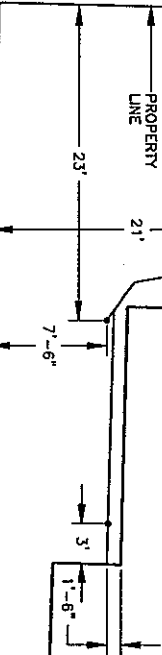

• CLEANOUT

OWNER: VACANT
ADDRESS: 21405 40TH AVE. W.
CONTRACTOR: STELLAR DEV.
PERMIT NO.: U-98-024
ISSUE DATE:
INSPECTED BY: GRR
INSPECTION DATE: 6/12/98



CITY OF MOUNTLAKE TERRACE
DEPARTMENT OF COMMUNITY DEVELOPMENT

Side Sewer As-Built
21405 40th Avenue West
U-98-024

-SS

revision date
June 98