

TIMBER NE PARK
DEAN ECHELBARGER ~ DEVELOPER

The City of Mountlake Terrace

APPLICATION

for

SIDE SEWER PERMIT

OUTSIDE ☒ INSIDE ☐ REPAIRS ☐


CARD No. _____

EASEMENT No. _____

OWNER _____ CONTRACTOR UNIVERSAL LIT'L CO. INC.
EDMONDS, WASH.

HOUSE No. 3601-225 Apt. 3 ~~3601-225~~ W STREET SIDE SEWER TO LOT LINE PERMIT No. 74-14
AVENUE LOT No. 29 BLOCK No. 1974

NAME ADD _____

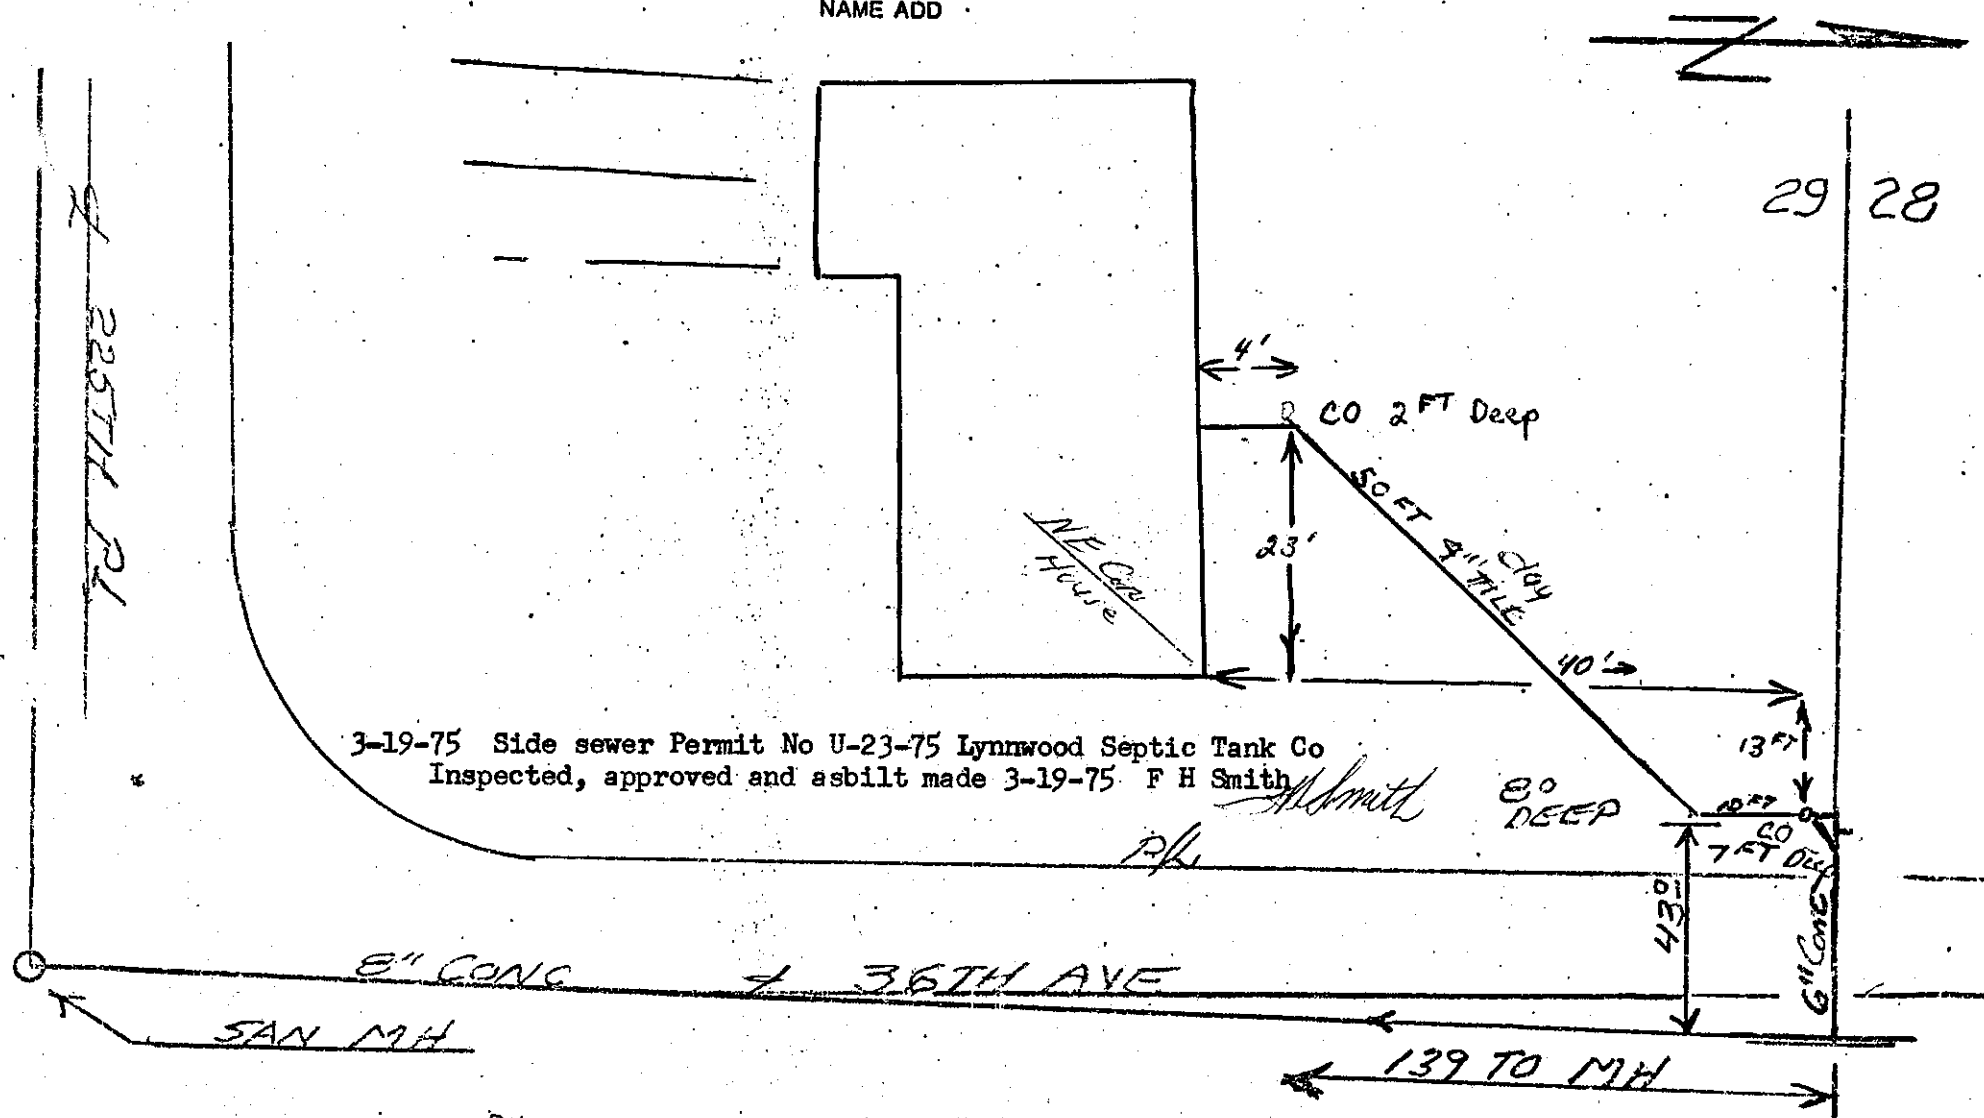

3-19-75 Side sewer Permit No U-23-75 Lynnwood Septic Tank Co
Inspected, approved and asbilt made 3-19-75 F H Smith

BACKFILL WORK ORDER ISSUED 7-7-74 DEPOSIT, \$ _____
SEWER WORK ORDER ISSUED 7-7-74

Approved: _____