


21416 40TH AVE. W.

40TH AVE. W.

● CLEANOUT


OWNER: VACANT
ADDRESS: 21416 40TH AVE. W.
CONTRACTOR: STELLAR DEV.
PERMIT NO.: U-99-049
ISSUE DATE:
INSPECTED BY: GRR
INSPECTION DATE: 10/15/98

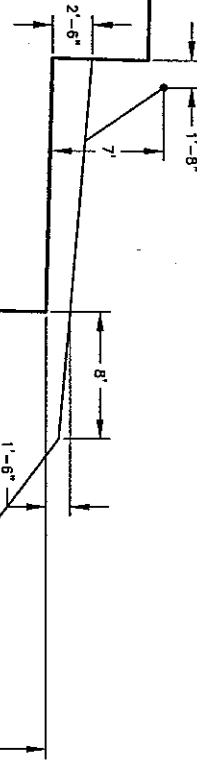

DRAWING NO.: -SS		DRAWN BY: DEE		APPROVED BY: /		DATE:	
CHECKED BY:		PROJECT ENGINEER		DESCRIPTION			
HORIZONTAL SCALE:	REVISION	DATE					
VERTICAL SCALE:							
CADD FILE PATH/NAME: H:\HOME\JAMISON\ENGINEERING\SIDESEWER\21416_40THAVE.W.DWG							

CITY OF MOUNTLAKE TERRACE
SEWER AS-BUILTS

RESIDENTIAL SIDE SEWER DRAWING



MOUNTLAKE TERRACE
COMMUNITY DEVELOPMENT

ENGINEERING DEPARTMENT

CITY OF MOUNTLAKE TERRACE
23204 58TH AVENUE WEST
MOUNTLAKE TERRACE, WA 98043
(425) 776-1161
FAX (425) 776-8421