

APPLICATION

CARD No.

The City of Mountlake Terrace

SIDE SEWER PERMIT

OUTSIDE ☒ INSIDE ☐ REPAIRS ☐

EASEMENT No.

Developer H & H Homes

Prime Universal Util Cont

OWNER

CONTRACTOR Side Sewer Lynnwood Septic Tank

74-18
PERMIT No.

HOUSE No.


22301 66th Place S W

STREET

AVENUE LOT No. Greenridge Lot 3

BLOCK No.

NAME ADD

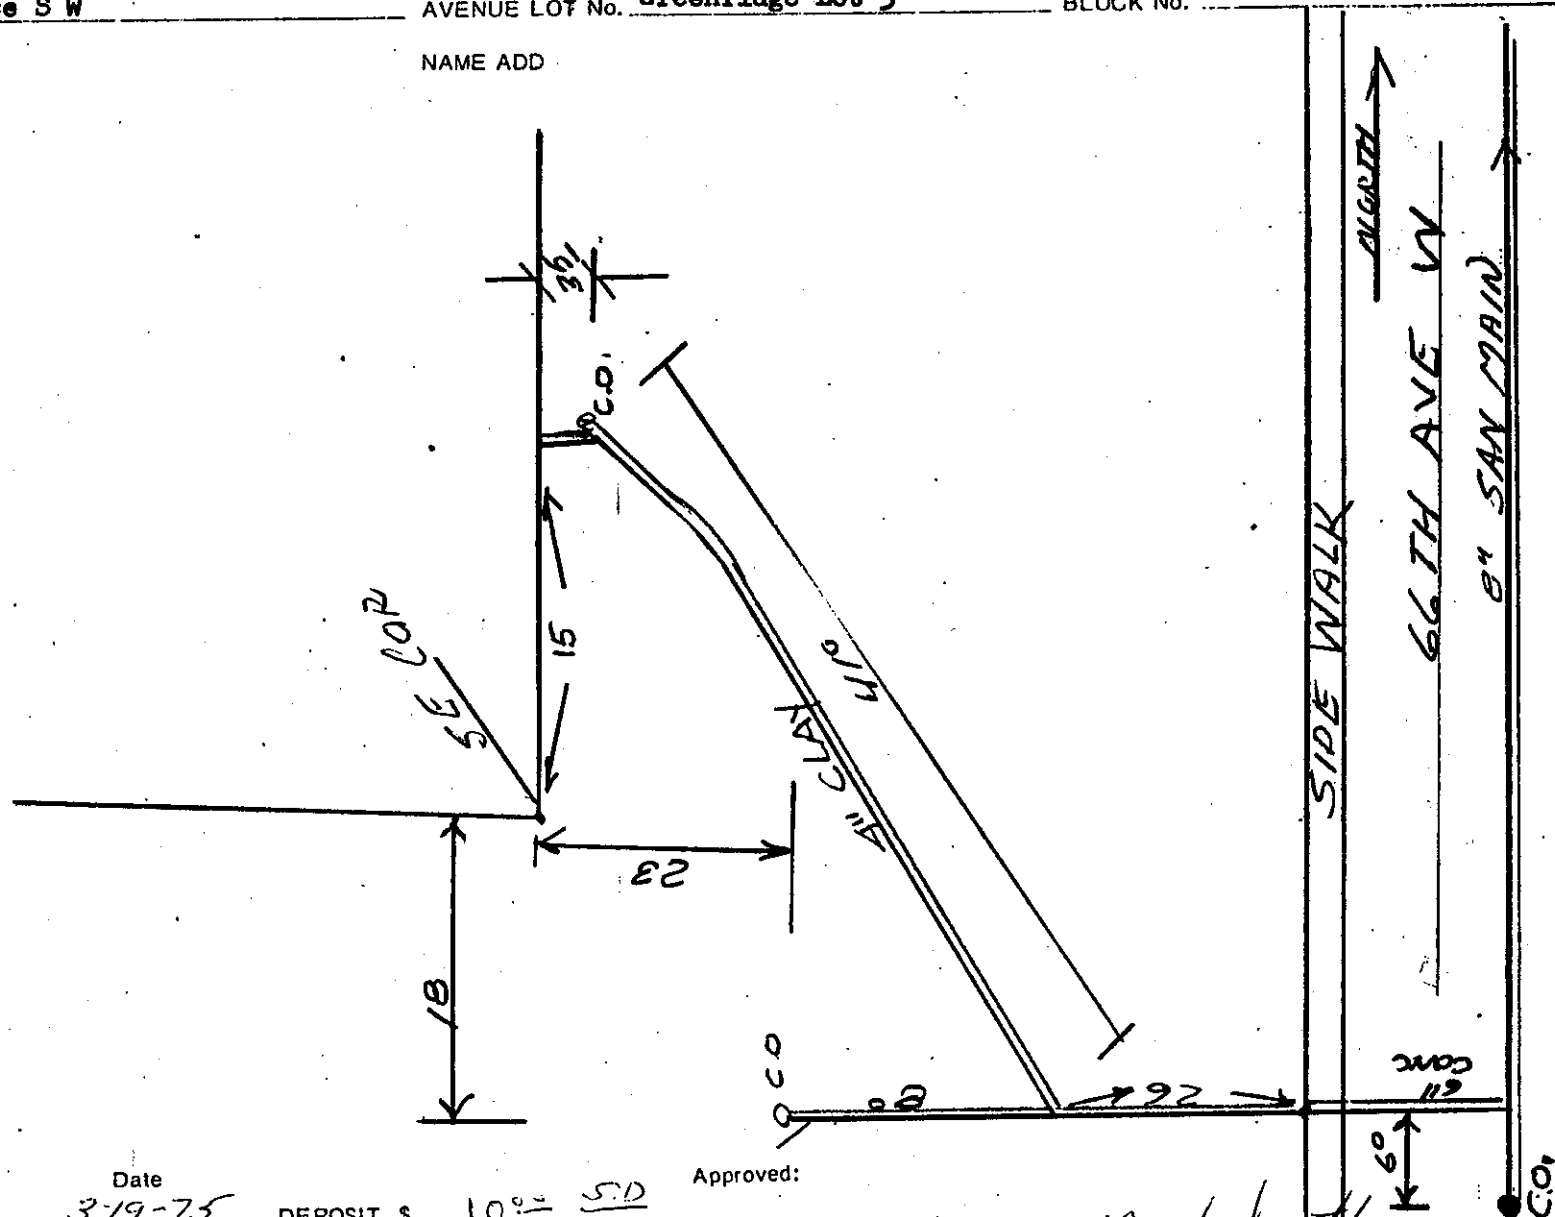

DID NOT USE

BACKFILL WORK ORDER ISSUED

Date 3-19-75

DEPOSIT, \$

10.00

Approved:

DATE

3-19-75

BY

Fred Smith