

# APPLICATION

for

SIDE SEWER PERMIT

OUTSIDE ☒ INSIDE ☐ REPAIRS ☐

CARD No. \_\_\_\_\_

EASEMENT No. \_\_\_\_\_

The City of Mountlake Terrace

OWNER Wm. Landin

CONTRACTOR Wingfield

PERMIT No. 2934

HOUSE No. 5902 - 222nd SW.


STREET

AVENUE LOT No. \_\_\_\_\_

BLOCK No. \_\_\_\_\_

NAME ADD. \_\_\_\_\_

8" Sewer Main

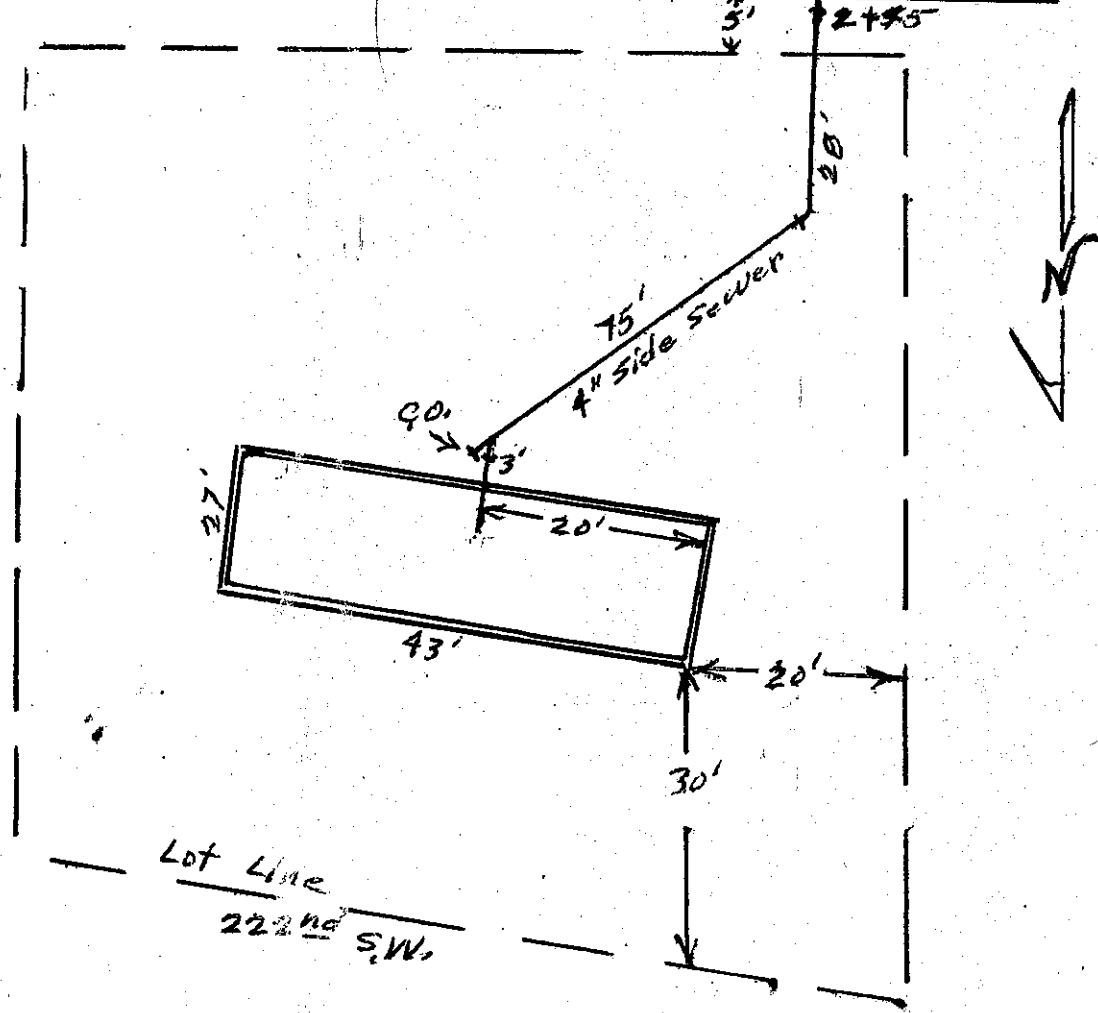

Lot Line  
222nd SW.

Date \_\_\_\_\_

Approved: \_\_\_\_\_

BACKFILL WORK ORDER ISSUED \_\_\_\_\_

DEPOSIT, \$ \_\_\_\_\_

SEWER WORK ORDER ISSUED \_\_\_\_\_

DATE

10-24-61 BY S. M. Holton