

APPLICATION

FOR

SIDE SEWER PERMIT

CARD No. _____

The City of Mountlake Terrace


OUTSIDE ☐ INSIDE ☒ REPAIRS ☐

EASEMENT No. _____

OWNER Elmer V. Moss CONTRACTOR Synowood Septic Tank Co. PERMIT No. 3089

HOUSE No. 4407 STREET 13 AVENUE LOT No. 13 BLOCK No. 242 pl SW

NAME ADD Terrace Ridge

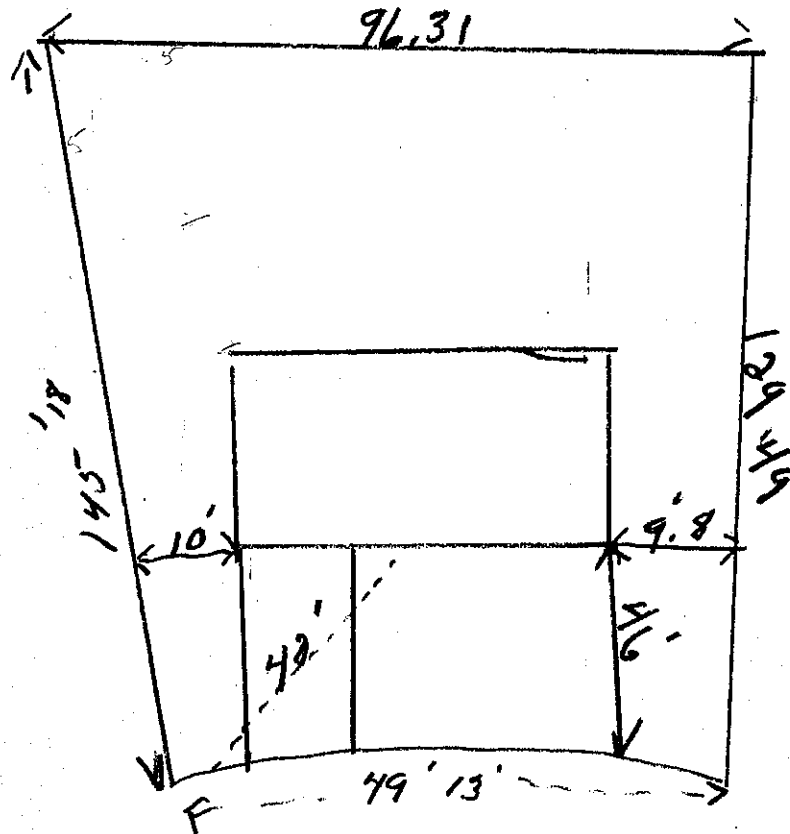

CITY OF
MOUNTLAKE TERRACE

MAY 10 1962

Plan Approved _____

BACKFILL WORK ORDER ISSUED _____ Date _____
SEWER WORK ORDER ISSUED _____ DEPOSIT, \$ _____

Approved:

DATE

5/10/62

BY

E. J. Lake

Elly Permit # 2181