

The City of Mountlake Terrace

APPLICATION

CARD No.

SIDE SEWER PERMIT

OUTSIDE ☒ INSIDE ☐ REPAIRS ☐

EASEMENT No.

H & H Homes P O Box 644 Lynnwood, Wash 98036

OWNER

Universal Utility Contractors Inc.

CONTRACTOR 11/11/ 203rd St N E Woodenville

PERMIT No. 74-18

HOUSE No. 6701 224TH ST SW

STREET


AVENUE LOT No. 10

BLOCK No.

NAME ADD Greenridge

Side Sewer Permit No U-34-75 issued April 28, 1975 to Lynnwood Septic Tank Co.
Installed, inspected, accepted and asbilt drawn 4/28/75 F H Smith

GARAGE

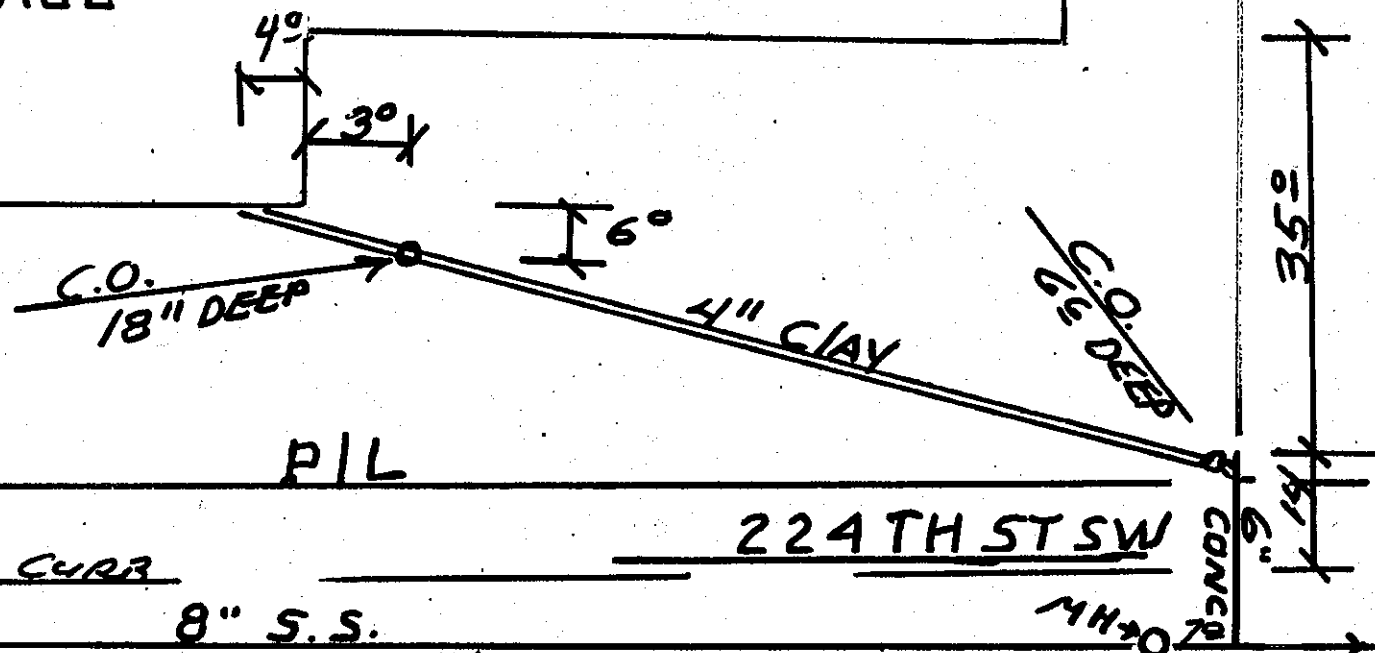

JACKFILL WORK ORDER ISSUED. June 14 1974

SEWER WORK ORDER ISSUED May 16 1974

DEPOSIT, \$

Approved:

June 20, 1974

DATE

BY

Fred H. Smith