

The City of Mountlake Terrace

APPLICATION

SIDE SEWER PERMIT

OUTSIDE ☐ INSIDE ☐ REPAIRS ☐


CARD No. _____

EASEMENT No. _____

OWNER _____ CONTRACTOR Lynwood Septic Tank Co PERMIT No. U-50-75

HOUSE No. 3603 224th Place S W STREET 24 AVENUE LOT No. 24 BLOCK No. _____

NAME ADD Timberline Park

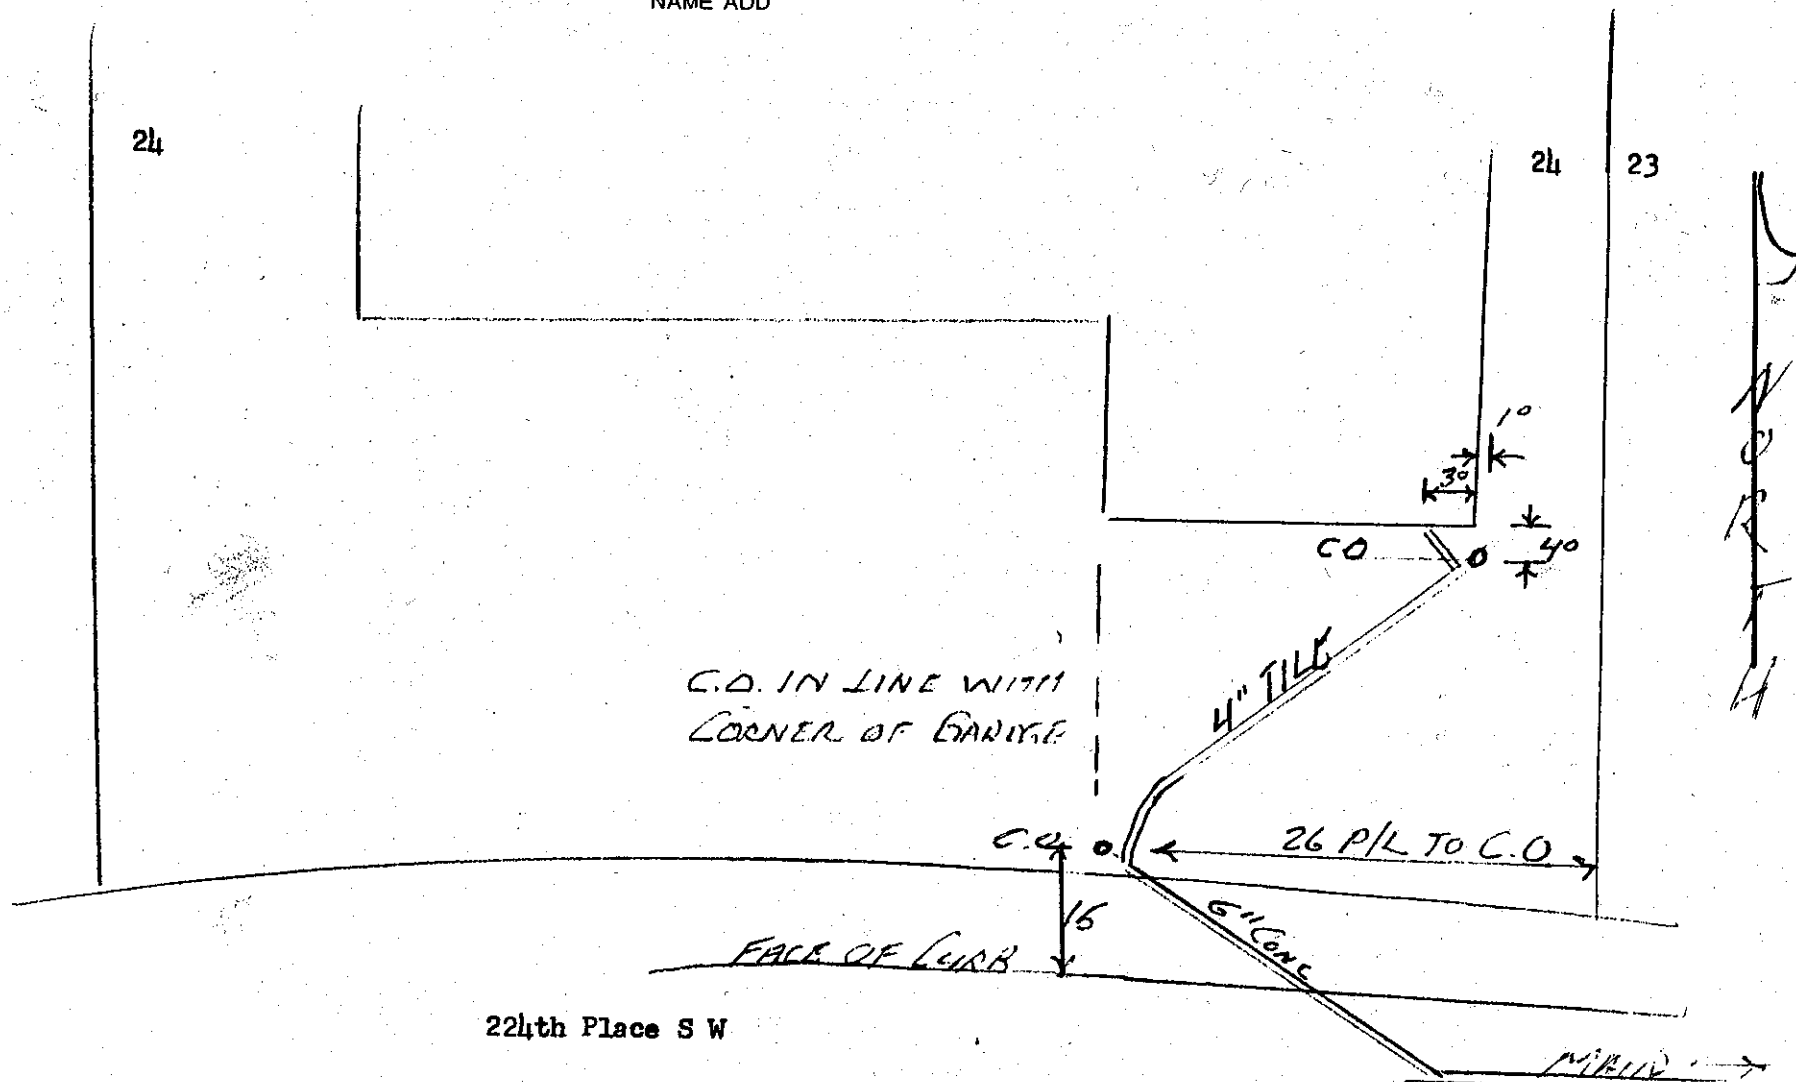

224th Place S W

BACKFILL WORK ORDER ISSUED 7-2-75 DEPOSIT, \$ \$10
SEWER WORK ORDER ISSUED 7-2-75

Approved: _____
DATE 7-2-75 BY Ray H. Smith