

TIMBERLINE PARK

DEAN ECHELBERGER ~ DEVELOPER

The City of Mountlake Terrace

APPLICATION

for

SIDE SEWER PERMIT

OUTSIDE ☒ INSIDE ☐ REPAIRS ☐

CARD No. \_\_\_\_\_


EASEMENT No. \_\_\_\_\_

OWNER \_\_\_\_\_ CONTRACTOR UNIVERSAL UTIL. CO. INC.

HOUSE No. 22405 36TH AVE W STREET EDMONDS, WASH. PERMIT No. 74-14

AVENUE LOT No. 11 BLOCK No. 7

NAME ADD \_\_\_\_\_

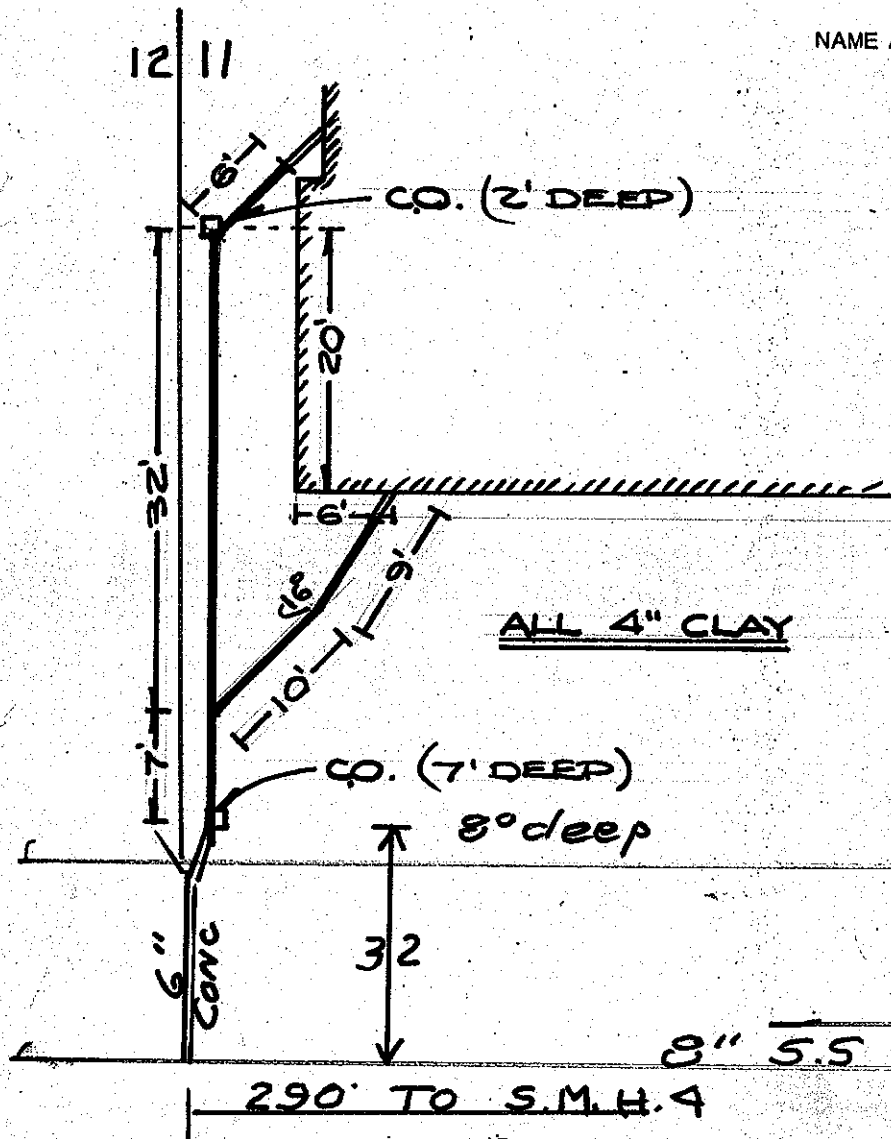

★ PERMIT NO. UA-75-53  
ISSUED TO LYNNWOOD SEPTIC  
TANK. INSPECTED & APPROVED  
7-28-75 ... W.H. VAN RY ★

BACKFILL WORK ORDER ISSUED 7-1-74 DEPOSIT, \$ \_\_\_\_\_  
SEWER WORK ORDER ISSUED 4-15-74 DATE 8-74 BY F.H. SMITH  
MAIN & SERVICE TO DII