

The City of Mountlake Terrace

APPLICATION

SIDE SEWER PERMIT

OUTSIDE ☒ INSIDE ☐ REPAIRS ☐

CARD No.

EASEMENT No.

OWNER KENNETH J. ELLIN

CONTRACTOR OWNER


PERMIT No. 798

HOUSE No. 23208 63RD WEST

STREET
AVENUE LOT No. 25

BLOCK No. 46

NAME ADD.

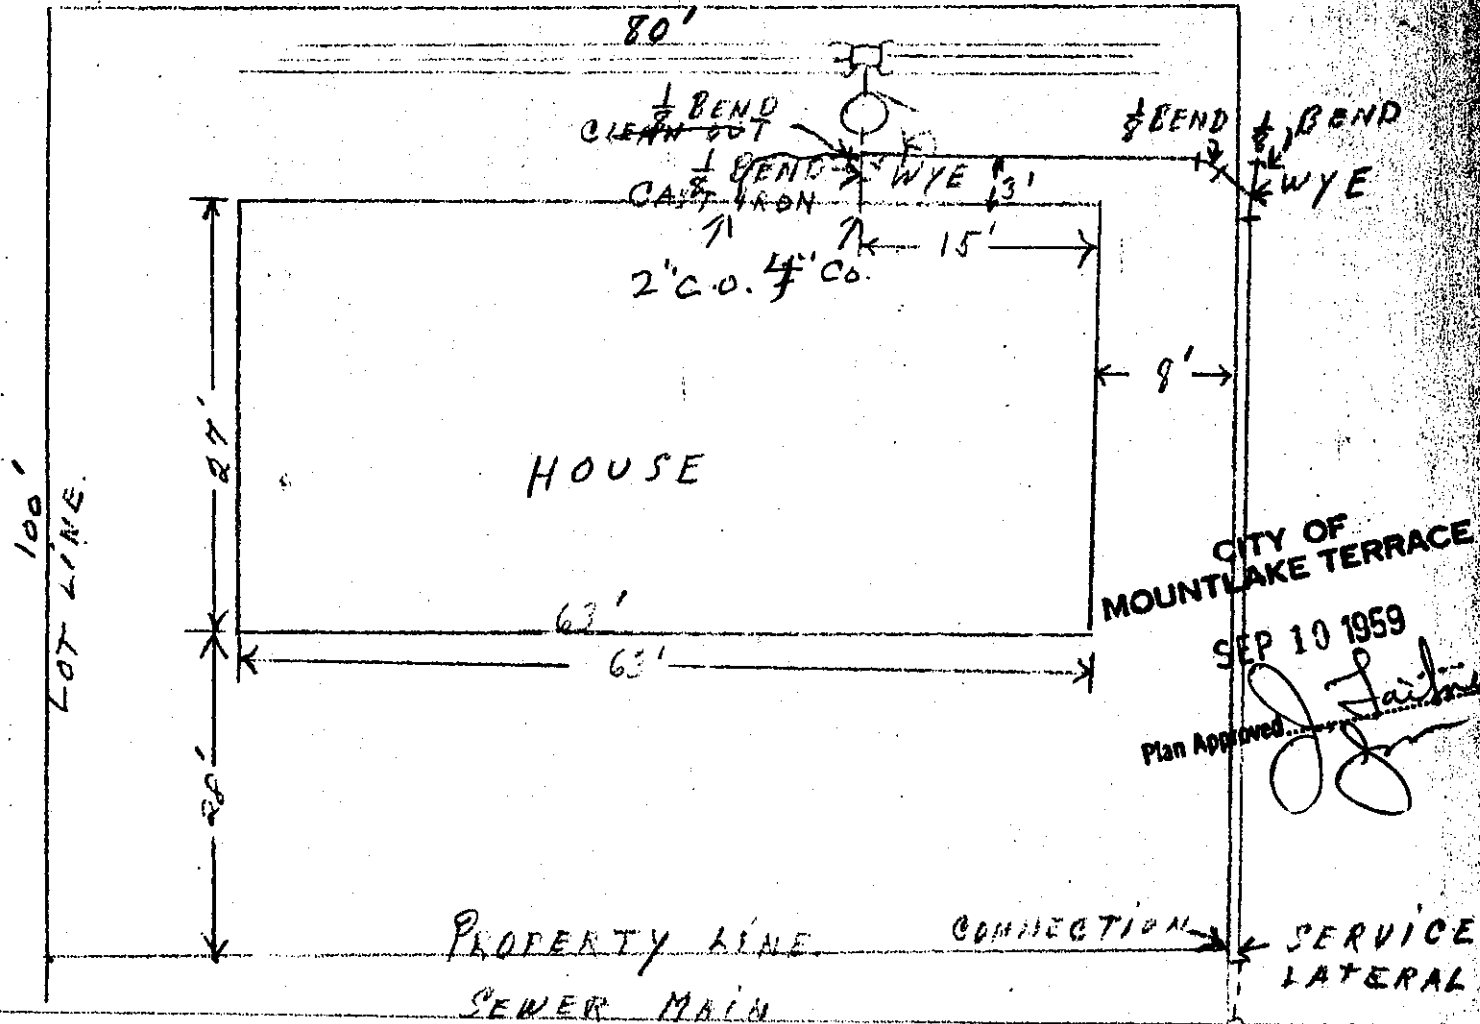

CITY OF
MOUNTLAKE TERRACE

SEP 10 1959

Plan Approved

James

PROPERTY LINE

CONNECTION

SERVICE
LATERAL

SEWER MAIN

Date

Approved:

BACKFILL WORK ORDER ISSUED

DEPOSIT, \$

SEWER WORK ORDER ISSUED

DATE

BY

#4340

9/11/59

3-17-60 INS & CON

Ellman insp. u.c.