

APPLICATION

CARD No. _____

The City of Mountlake Terrace

SIDE SEWER PERMIT


OUTSIDE ☐ INSIDE ☐ REPAIRS ☐

EASEMENT No. _____

OWNER Parkwood Homes Inc CONTRACTOR Lynnwood Septic tank co PERMIT No. 3922

HOUSE No. 4404 219th STREET 16 AVENUE LOT No. 16 BLOCK No. Tract 39

NAME ADD Cedar Park

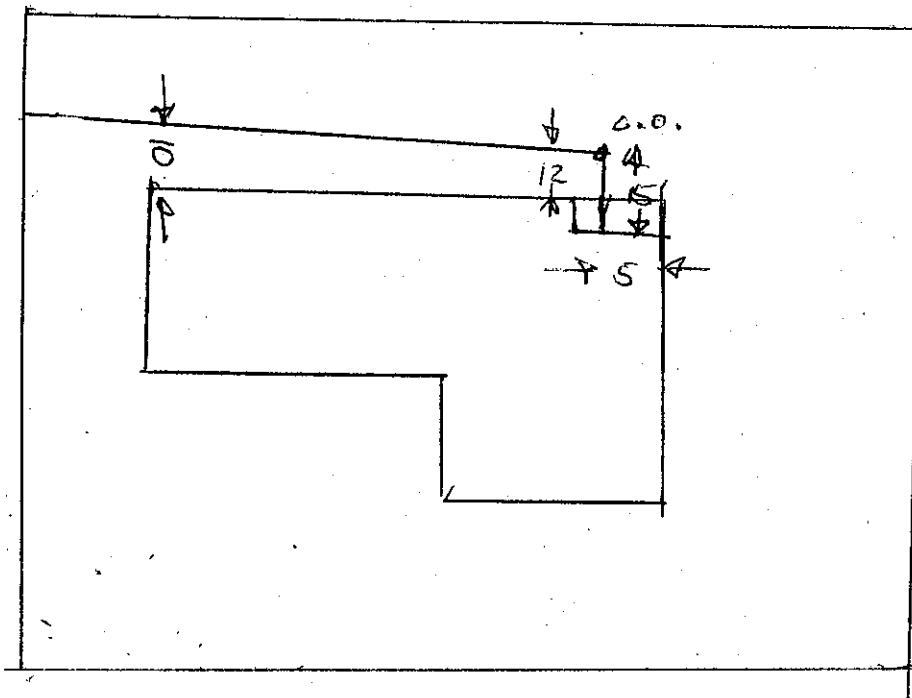

Date

Approved:

BACKFILL WORK ORDER ISSUED _____ DEPOSIT, \$ _____

SEWER WORK ORDER ISSUED _____

DATE 9-8-65 BY R. Bal