



DATE	
BY	DA
REVISION	
NO.	1
PLAN	NO. 1
NOTE BOOK	NO. 1
NO.	1

DATE	
BY	DA
REVISION	
NO.	1
PLAN	NO. 1
NOTE BOOK	NO. 1
NO.	1

DATE	
BY	DA
REVISION	
NO.	1
PLAN	NO. 1
NOTE BOOK	NO. 1
NO.	1

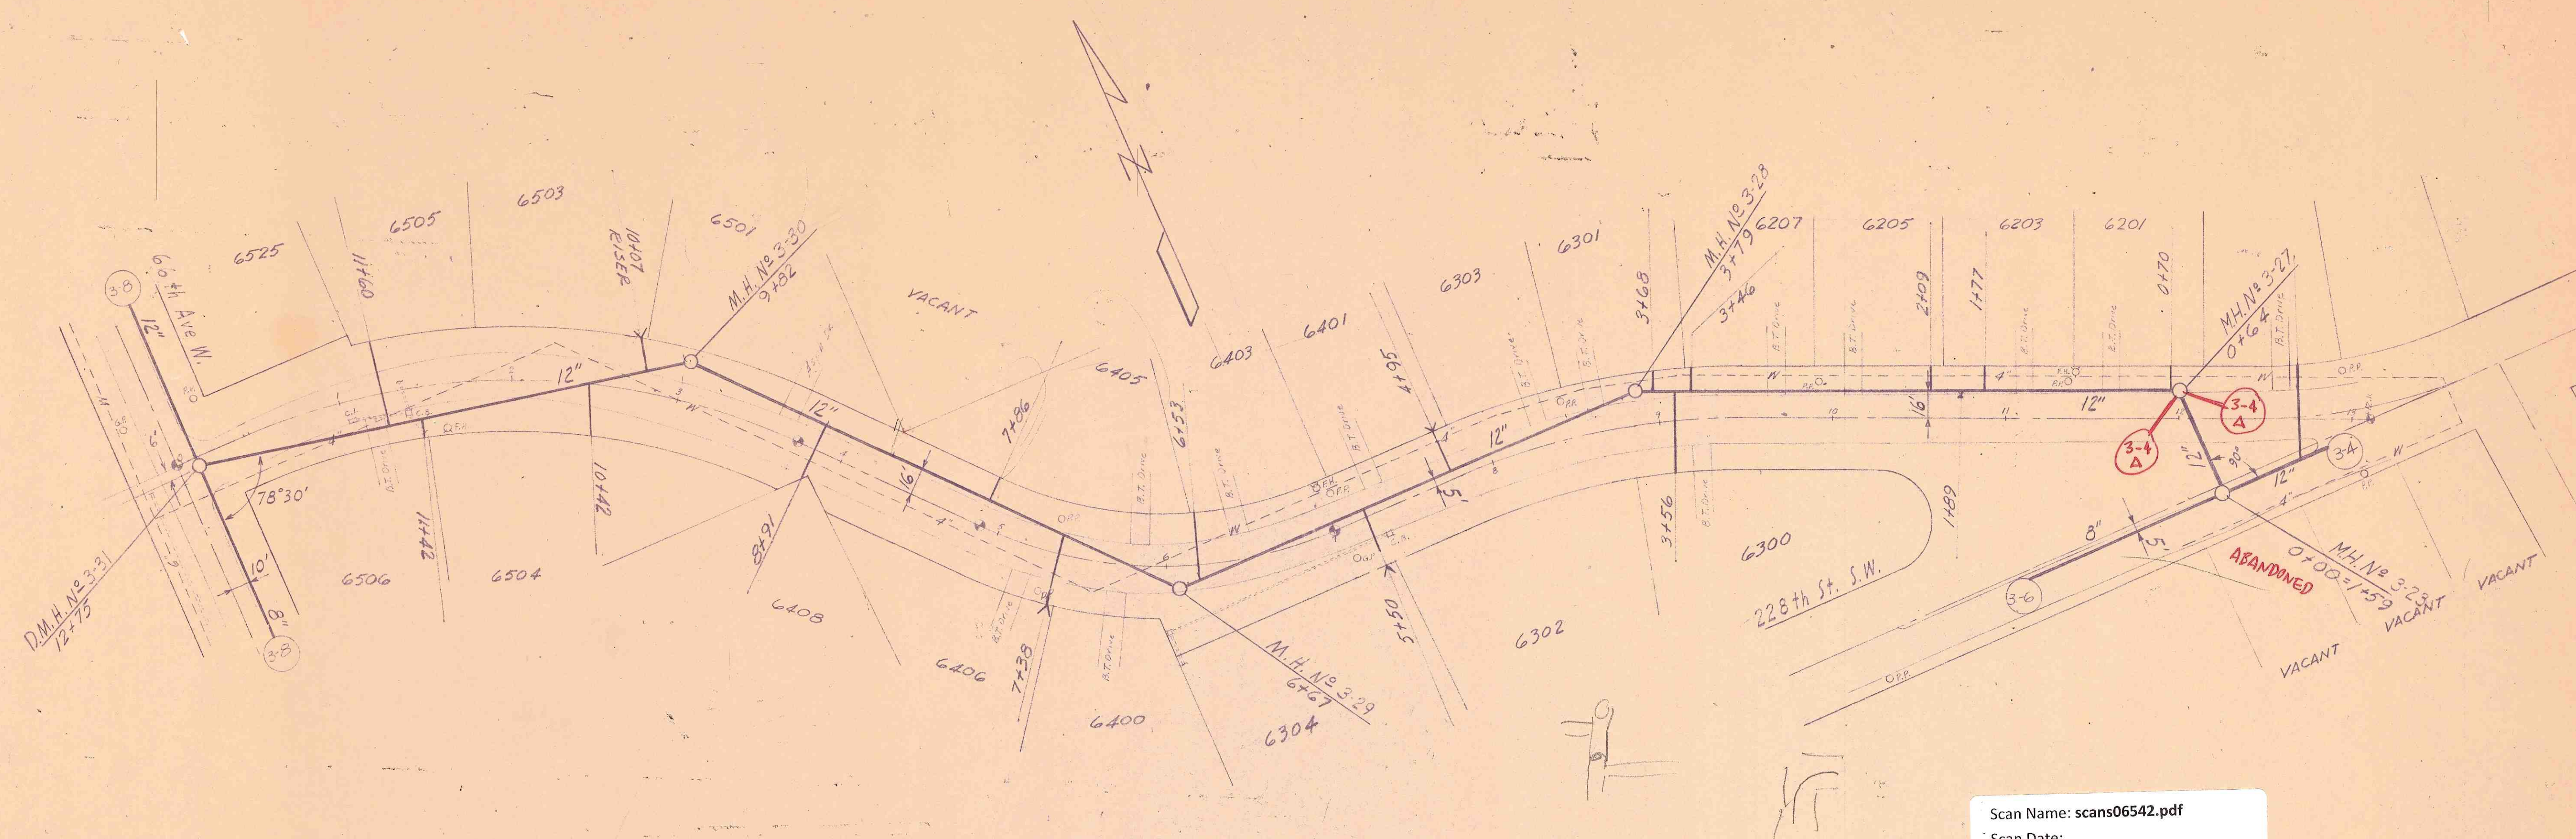

Scan Name: scans06542.pdf
Scan Date:

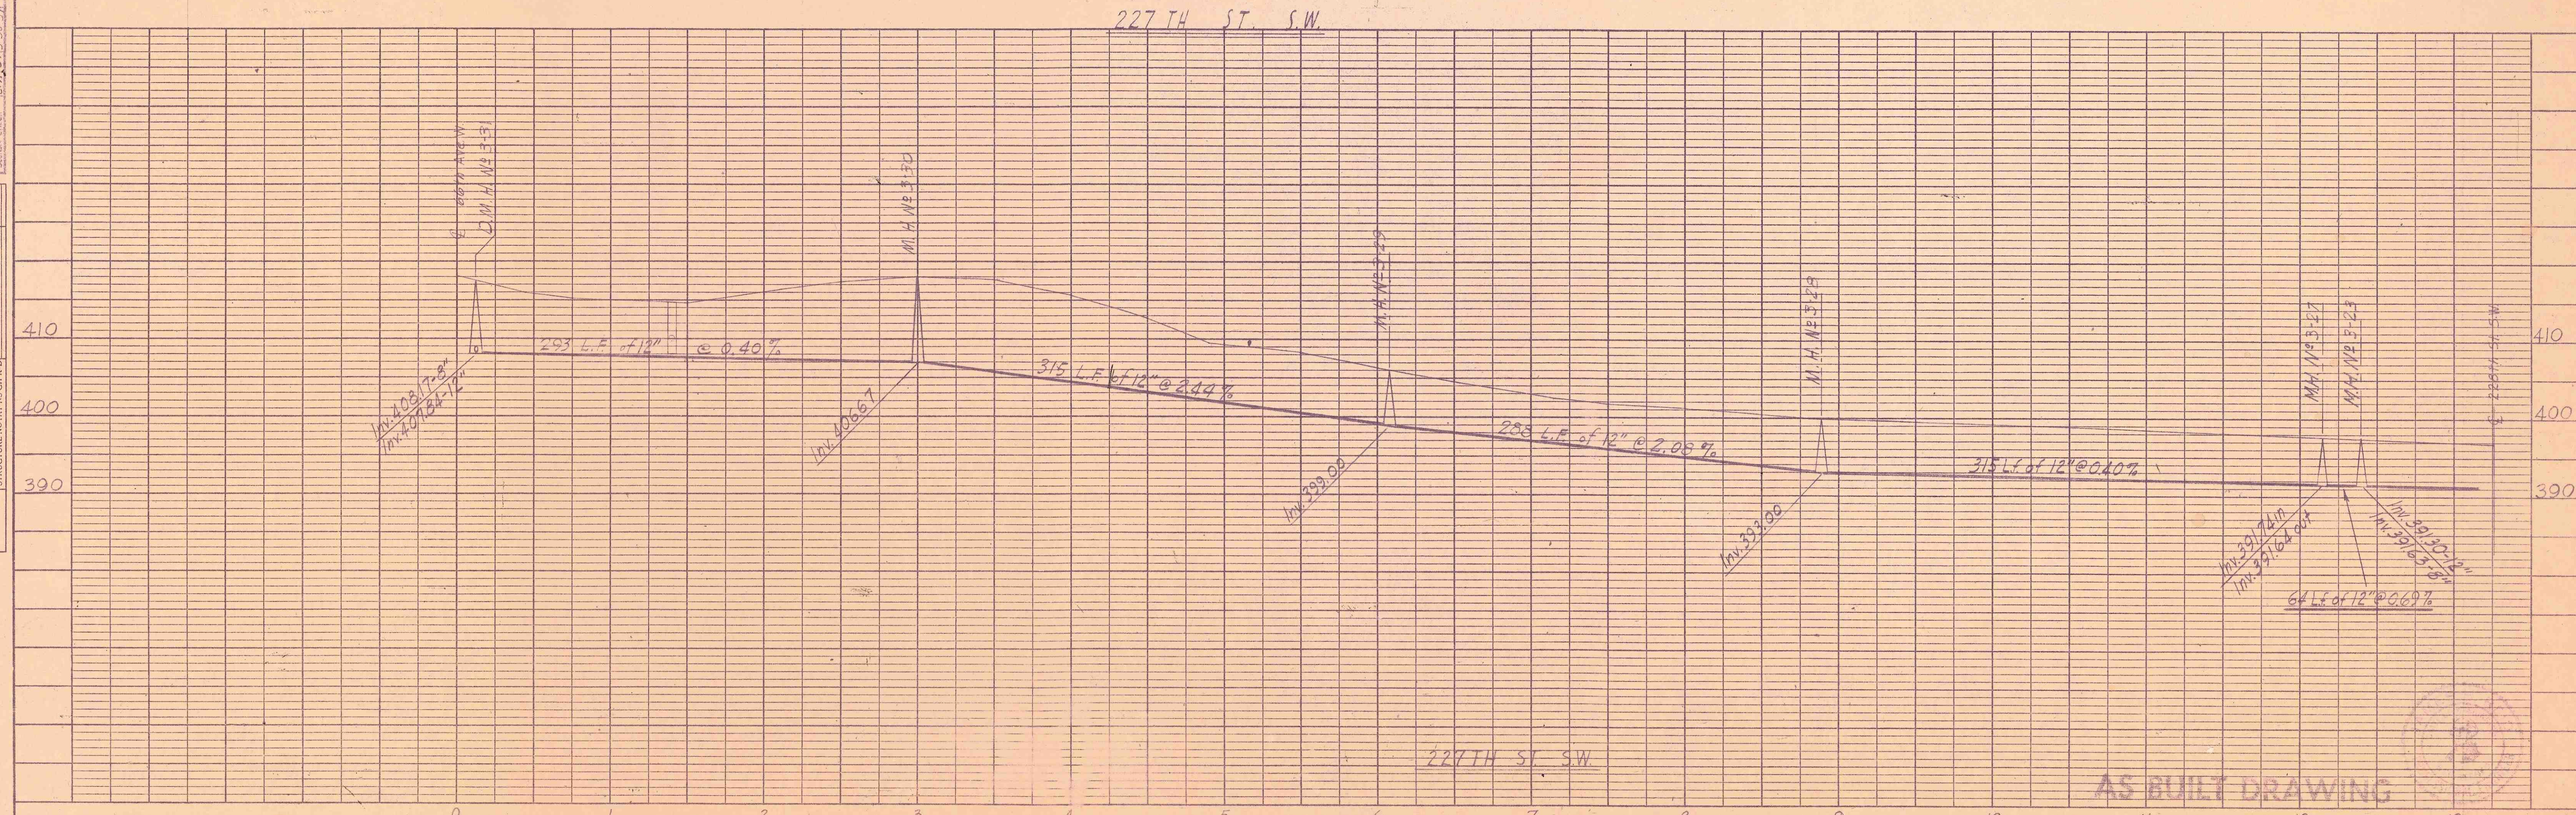

AS BUILT DRAWING