


- NOTES:**
1. FOR COORDINATE GEOMETRY OF UTILITY STRUCTURES, CLEANOUTS AND FITTINGS SEE DRAWING C32.
 2. MAKE SEWER AND LEACHATE BENDS WITH WYES AND 45 DEGREE ELBOWS.
 3. REFER TO DWG C32 FOR LEACHATE, SEWER AND WATER MAIN STRUCTURES AND COORDINATES. REFER TO DWG C33 FOR WATER MAIN PROFILES, DWG C36 FOR SEWER PROFILES, AND DWG C38 FOR LEACHATE PROFILES.
 4. ALL WORK RELATING TO INSTALLATION OF THE DDOV VAULT AND FW (FIRE SPRINKLER WATER) PIPING SHALL BE PERFORMED BY A WASHINGTON STATE LICENSED SPRINKLER CONTRACTOR.
 5. RECYCLING SITE YARD HYDRANT SUPPLIED BY DOMESTIC WATER SERVICE, PROTECTED BY REDUCED PRESSURE BACKFLOW PREVENTION ASSEMBLY AS SHOWN. ROUTE PIPING THROUGH OR AROUND BUILDINGS AS NECESSARY.
 6. LOCATE IRRIGATION SLEEVES ACROSS PAVED AREAS AS SHOWN ON DWGS L7 AND L8.
 7. FIRE HYDRANT ASSEMBLY AND GUARD POSTS PER MLT STD PLANS 201 & 212.

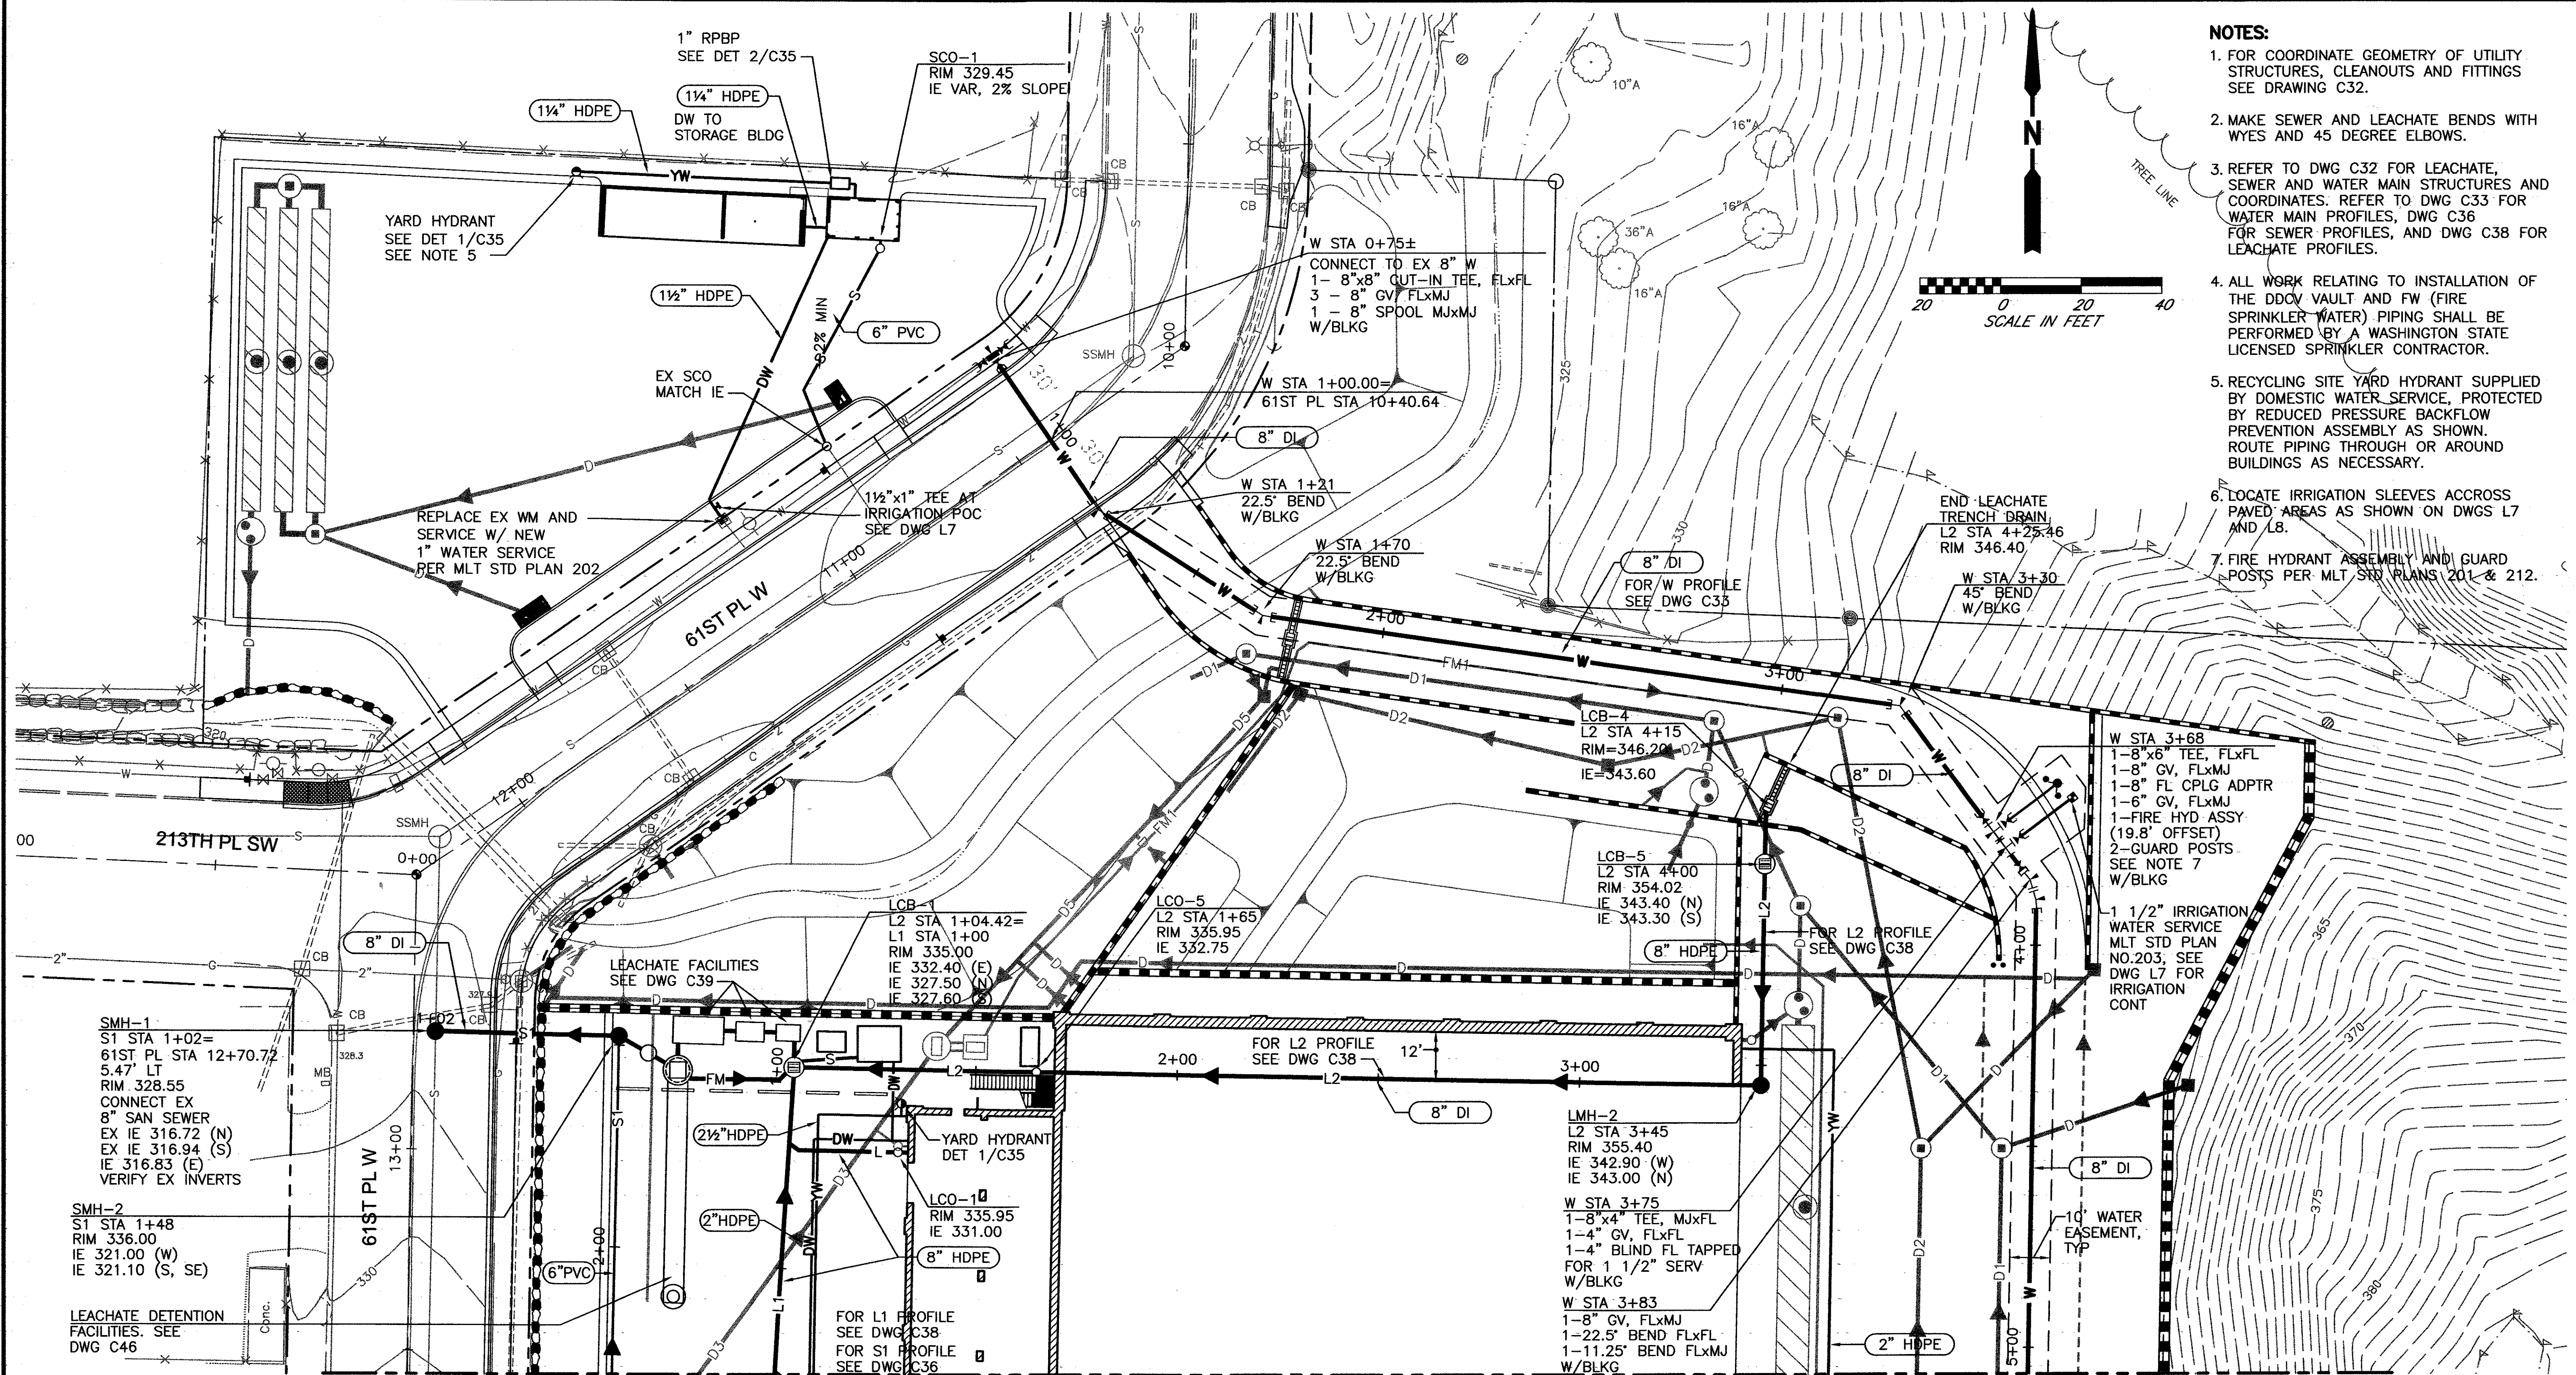

MATCH LINE - SEE DWG C31

PLAN CHECK	BY	DATE	REGION NO.	STATE	FED. AID PROJ. NO.	SHEET NO.
			10	WASH.		
			DESIGNED BY:	DRAWN BY:		
			J. SHARP	CAD TEAM		
			FIELD BOOK(S):	BAR IS ONE INCH ON ORIGINAL DRAWING		
			1045	IF NOT ONE INCH SCALE ACCORDINGLY		
DATE	NO.	REVISION	BY			
12/04		RECORD DRAWING				

Berryman
720 3rd Avenue, Ste 1200
Seattle, Washington 98104
206.505.3400
Fax 206.505.3406

RECORD DRAWING

These record drawings have been prepared based on construction records and as-built information provided by the contractor and others. Berryman and Henigar Inc. has not verified the accuracy and/or completeness of this information.

SNOHOMISH COUNTY
DEPARTMENT OF
PUBLIC WORKS

PROJECT NO. **SDC-5029**

SOLID WASTE MANAGEMENT DIVISION
SWRTS EXPANSION
NORTH UTILITIES PLAN

SURVEY NO.
3578
C30
SHEET
38
OF
187
SHEETS

291-02-69