


SIDE SEWER ABILT

OUTSIDE ☒ INSIDE ☐ REPAIRS ☐

OWNER Seabrook Development CONTRACTOR Lynwood Septic PERMIT NO. _____
HOUSE No. 4401 STREET 240th St SW AVENUE LOT NO. 240th St SW BLOCK NO. _____
NAME ADD. Summer Crest

240th St

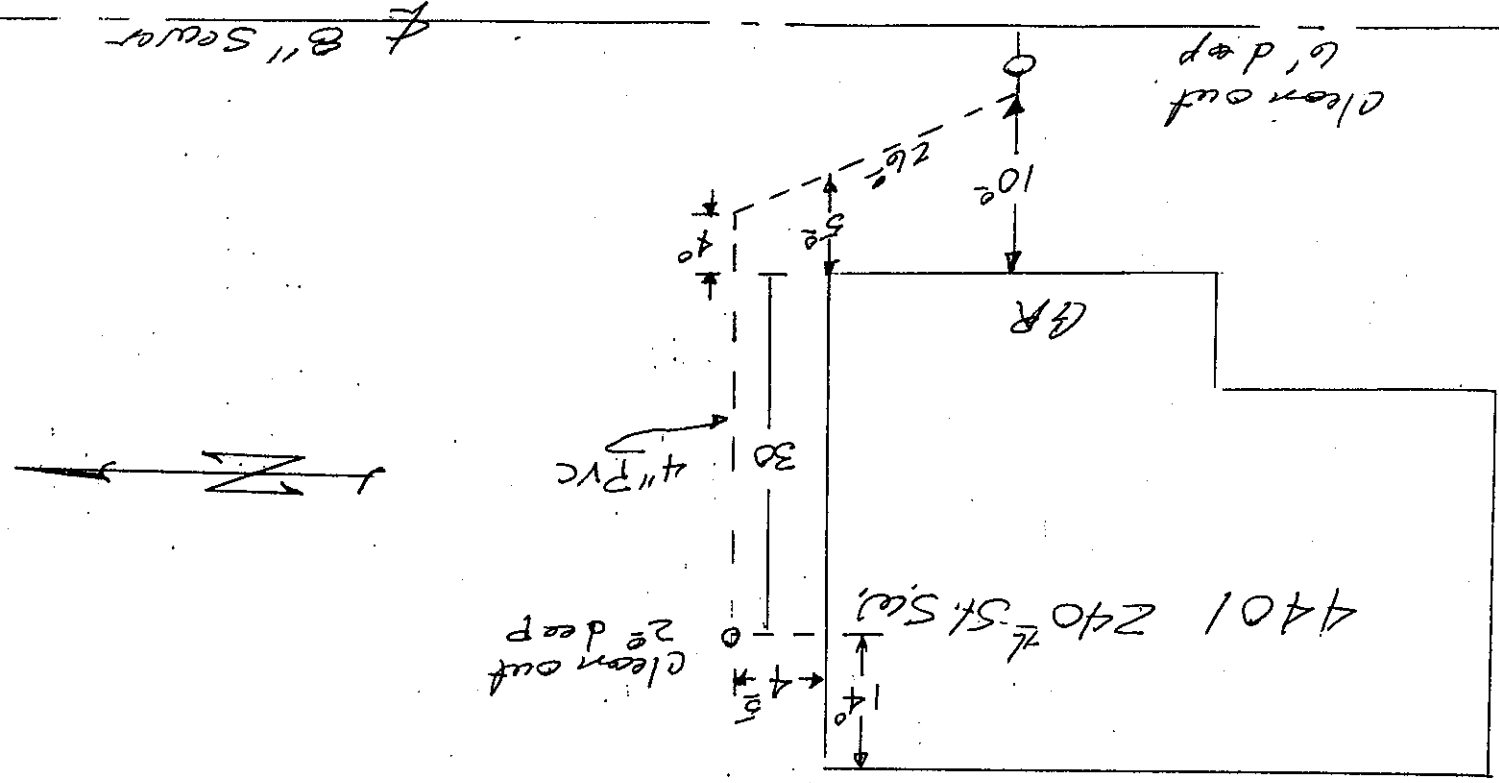

SEWER WORK ORDER ISSUED April 30, 1991 BY Betty Williams FEE 30.00 C.I. FEE _____
BACKFILL APPROVED May 2, 1991 BY Ben Len Dorr ASBILT May 3, 1991 BY Ben