


DATE	BY	SURVEYED	PLOTTED	GRADES CHECKED	B. M. 3 NOTED	STRUCTURE NOTATIONS CH'KD
10-20-50	D.P.					
11-18-50	D.P.					

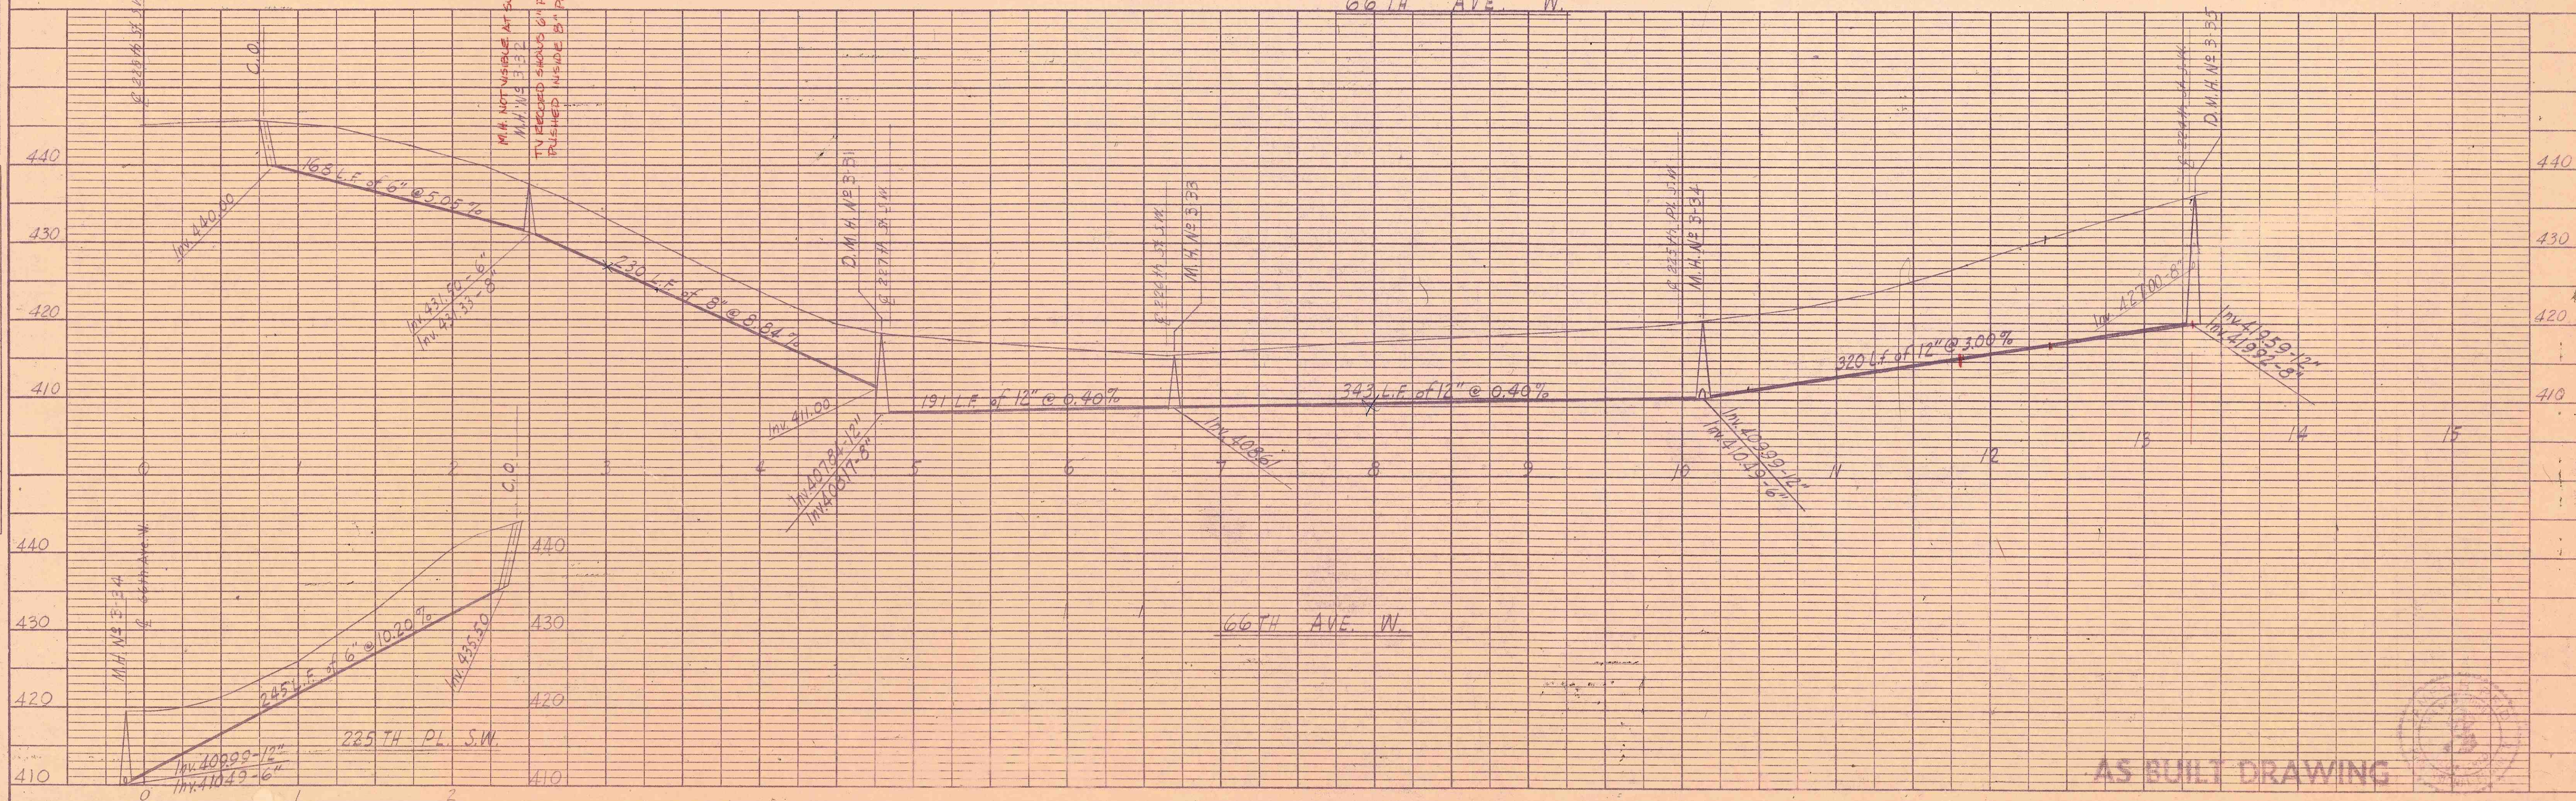

AS BUILT DRAWING