

# APPLICATION

for

SIDE SEWER PERMIT

OUTSIDE ☐ INSIDE ☒ REPAIRS ☐


2186

CARD No. \_\_\_\_\_

The City of Mountlake Terrace

EASEMENT No. \_\_\_\_\_

OWNER Elmer V Moss CONTRACTOR Lynnwood Septic Tank Co PERMIT No. 3201  
 HOUSE No. 4507 243 PL STREET 36 AVENUE LOT No. 36 BLOCK No. 243 p/s w  
 NAME ADD. Terrace Ridge

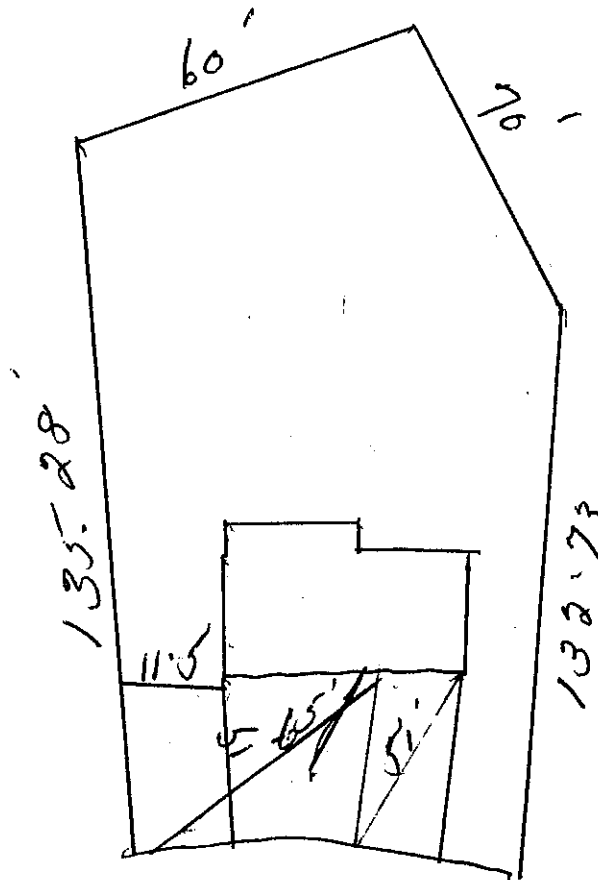

Date

Approved:

BACKFILL WORK ORDER ISSUED \_\_\_\_\_ DEPOSIT, \$ \_\_\_\_\_

SEWER WORK ORDER ISSUED \_\_\_\_\_

DATE \_\_\_\_\_ BY \_\_\_\_\_