


DATE	BY	SURVEYED	PROFILE
2-2-52	W.D.	PLOTTED	
		NOTE BOOK	
		GRADES CHECKED	
		B. M. NOTED	
		SHOW COR. CHECKED	
		STRUCTURE NOTATIONS CHECKED	

Estate of Maude S. McCormick
Deceased.

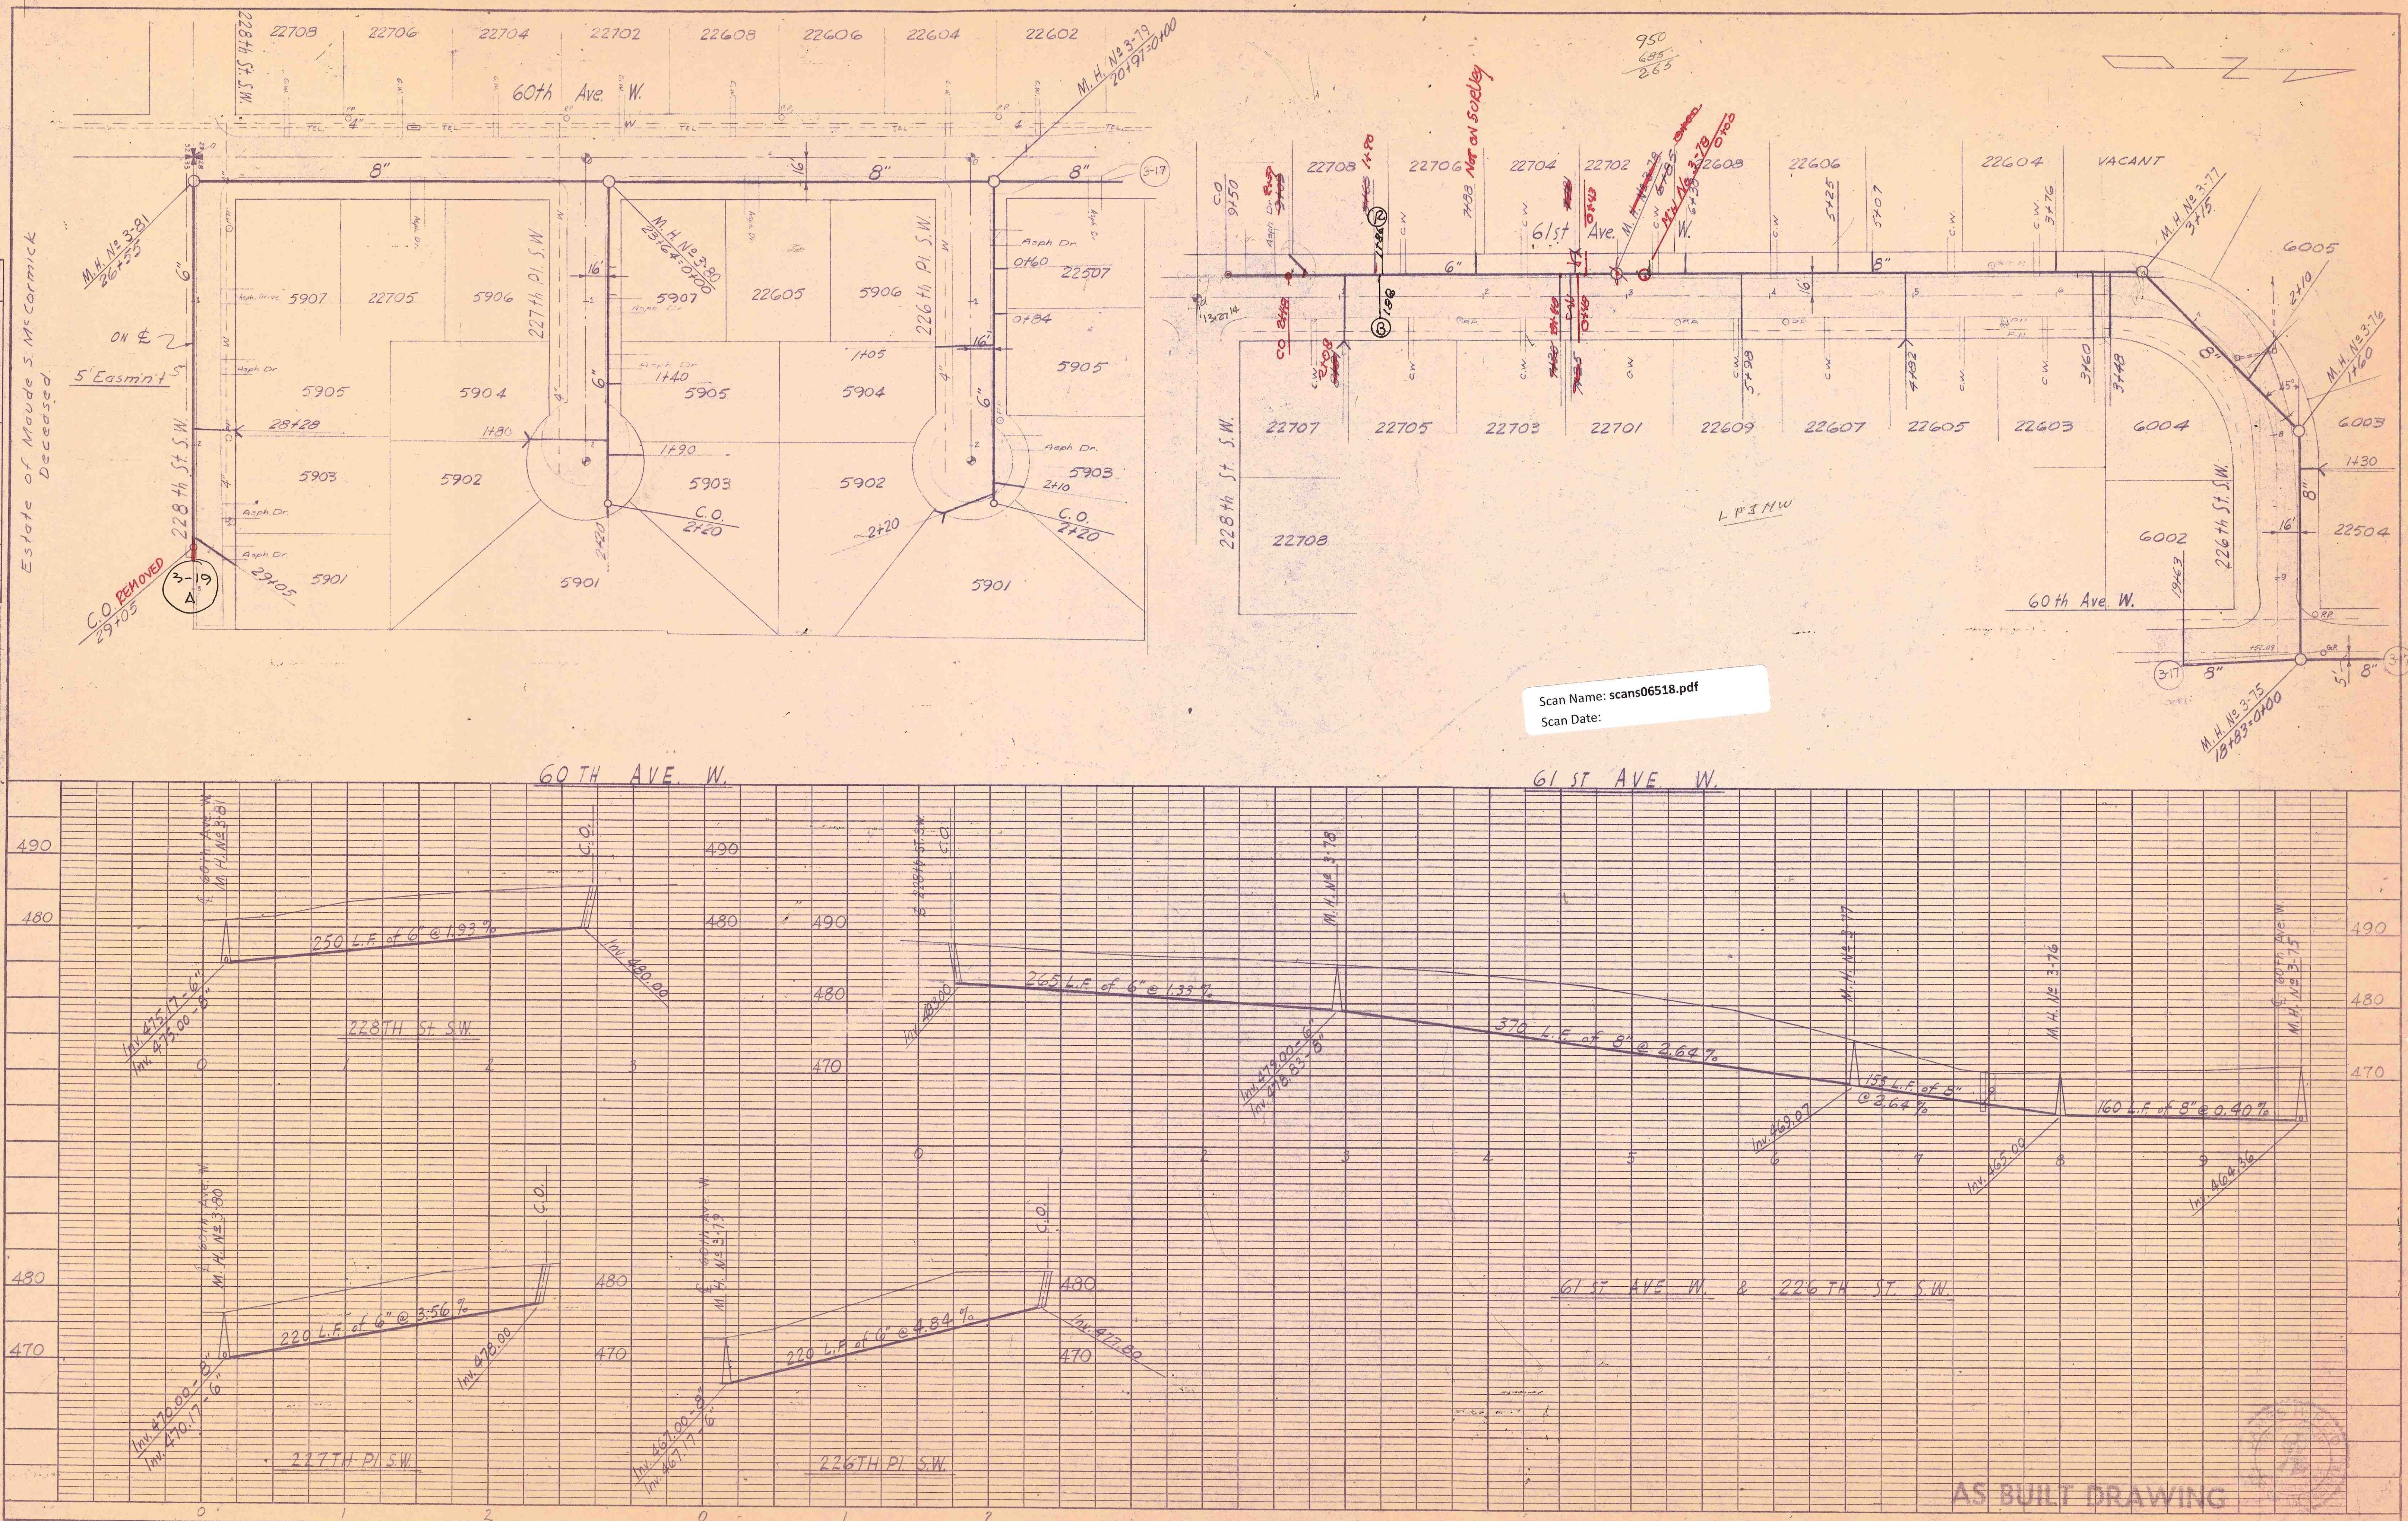

Scan Name: scans06518.pdf
Scan Date:

AS BUILT DRAWING

JAMES H. REID & ASSOCIATES
CONSULTING ENGINEERS, 324 MAIN ST., EDMONDS, WASH.

DESIGN L.N.	DRAWN H.H.D.P.	CHECKED L.N.	DATE 3-30-59	H. SCALE 1"=50' V. SCALE 1"=10'	FILE NO. 550/3-19 SHEET 19 OF 19
----------------	-------------------	-----------------	-----------------	------------------------------------	-------------------------------------

CITY OF MOUNTLAKE TERRACE
SEWERAGE SYSTEM UNIT 3