

# APPLICATION

CRIS KNUDSEN

The City of Mountlake Terrace

CARD No. \_\_\_\_\_

SIDE SEWER PERMIT  
OUTSIDE ☐ INSIDE ☒ REPAIRS ☐

EASEMENT No. \_\_\_\_\_

OWNER KRIS KNUDSEN

CONTRACTOR L.O. FRANKLIN & CO

PERMIT No. 1760


HOUSE No. 23710 - 52ND WEST

STREET  
AVENUE LOT No. \_\_\_\_\_

BLOCK No. \_\_\_\_\_

NAME ADD. \_\_\_\_\_

Beginning at the South East corner of the Knudsen Addition; thence to South 140 feet; West 35 feet; thence South 35 feet; West 80 feet; North 30 feet; West 151 feet; North 141 feet; thence East 301 feet to the true point of beginning.

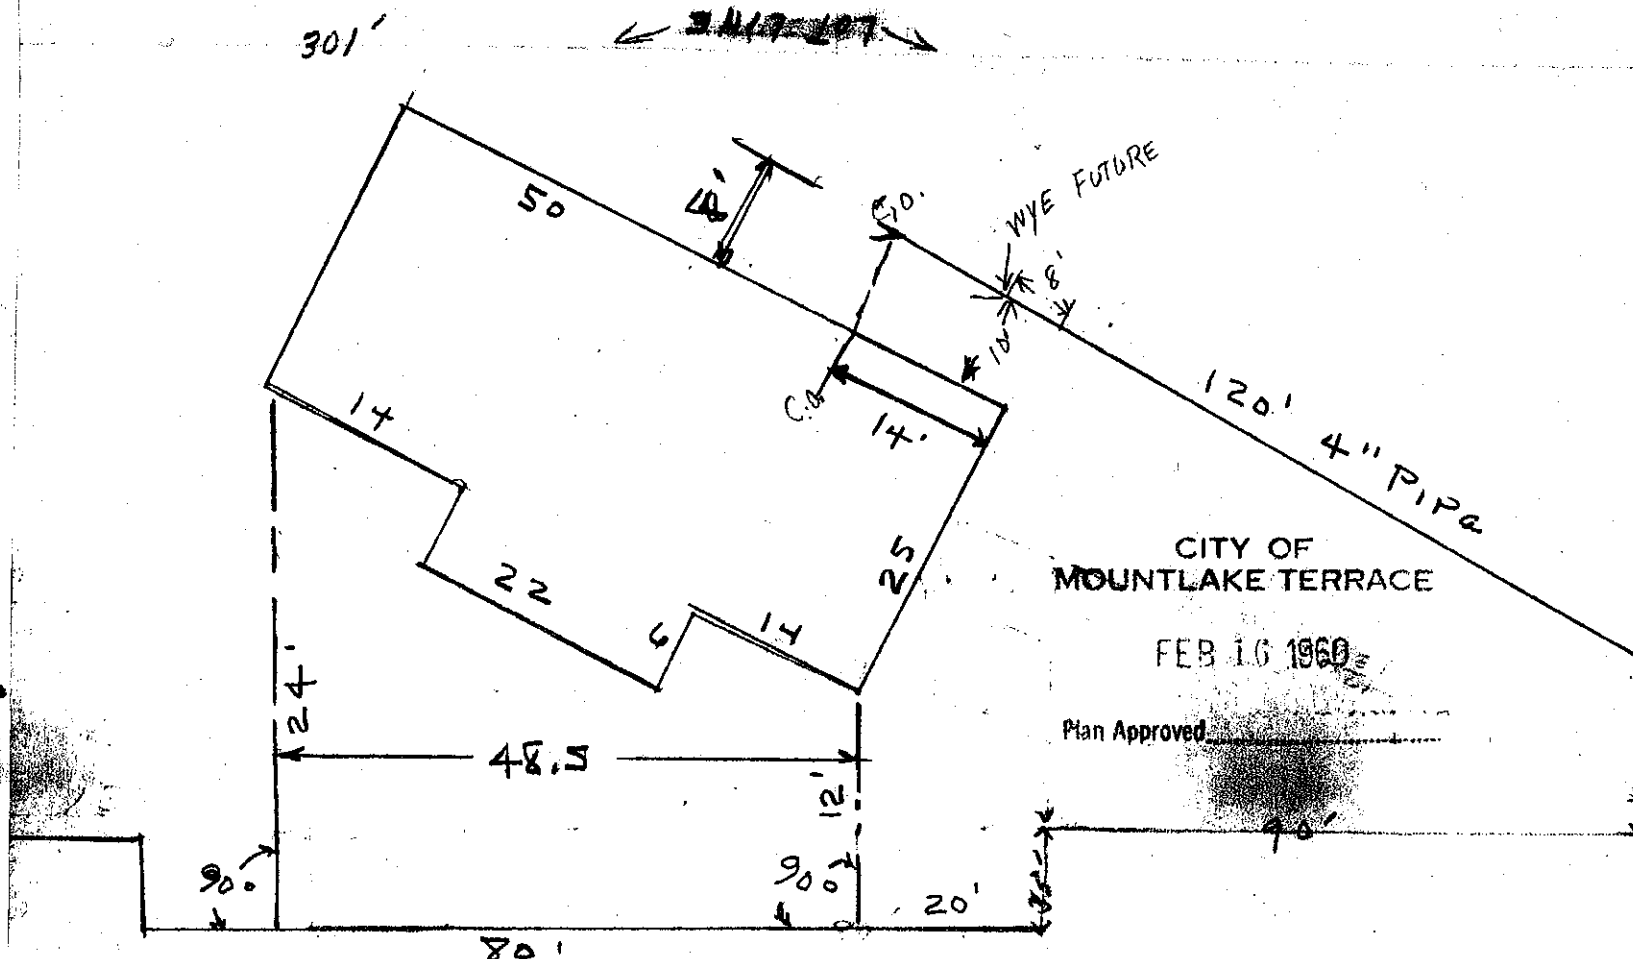

52ND MAIN - SEWER MAIN

CITY OF MOUNTLAKE TERRACE

FEB 16 1960

Plan Approved \_\_\_\_\_

Date

Approved:

BACKFILL WORK ORDER ISSUED \_\_\_\_\_

DEPOSIT, \$

SEWER WORK ORDER ISSUED \_\_\_\_\_

10.00

# 6014

2/12/60

DATE

2-17-60

BY

Scott M. Holton / MSACON