

The City of Mountlake Terrace

APPLICATION

for

SIDE SEWER PERMIT

OUTSIDE ☐ INSIDE ☐ REPAIRS ☐

CARD No. _____

EASEMENT No. _____

OWNER H & H Homes

CONTRACTOR Lynnwood Septic Tank

PERMIT No. U-26-75

HOUSE No. 22211 67 th Pl West


STREET
AVENUE LOT No. 14

BLOCK No. _____

NAME ADD Greenridge

Lot 14

Lot 13

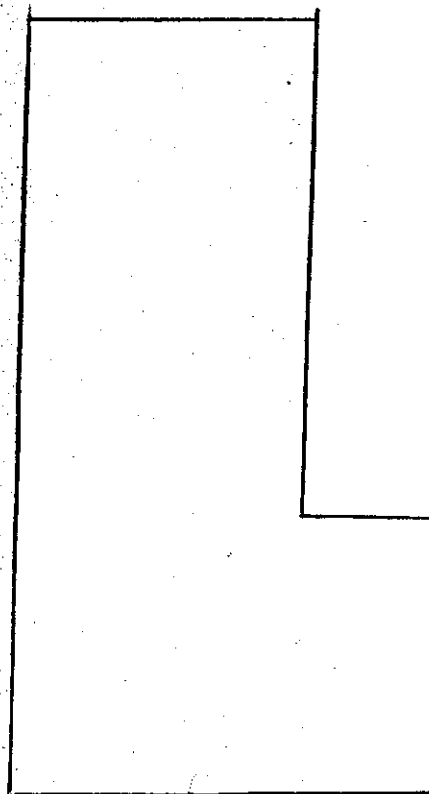

NORTH P/L

BACKFILL WORK ORDER ISSUED 3-21-75 DEPOSIT, \$ \$10
SEWER WORK ORDER ISSUED 3/21/75

Approved: _____
DATE 3/21/75 BY FH Smith