

The City of Mountlake Terrace

APPLICATION

for

SIDE SEWER PERMIT

OUTSIDE ☐ INSIDE ☒ REPAIRS ☐


CARD No. 2183

EASEMENT No.

OWNER Elmer V. Most CONTRACTOR Lynnwood Septic Tank Co. PERMIT No. 3072

HOUSE No. 4411 STREET 242 Pl. SW AVENUE LOT No. 242 Pl. SW BLOCK No. 11

NAME ADD.

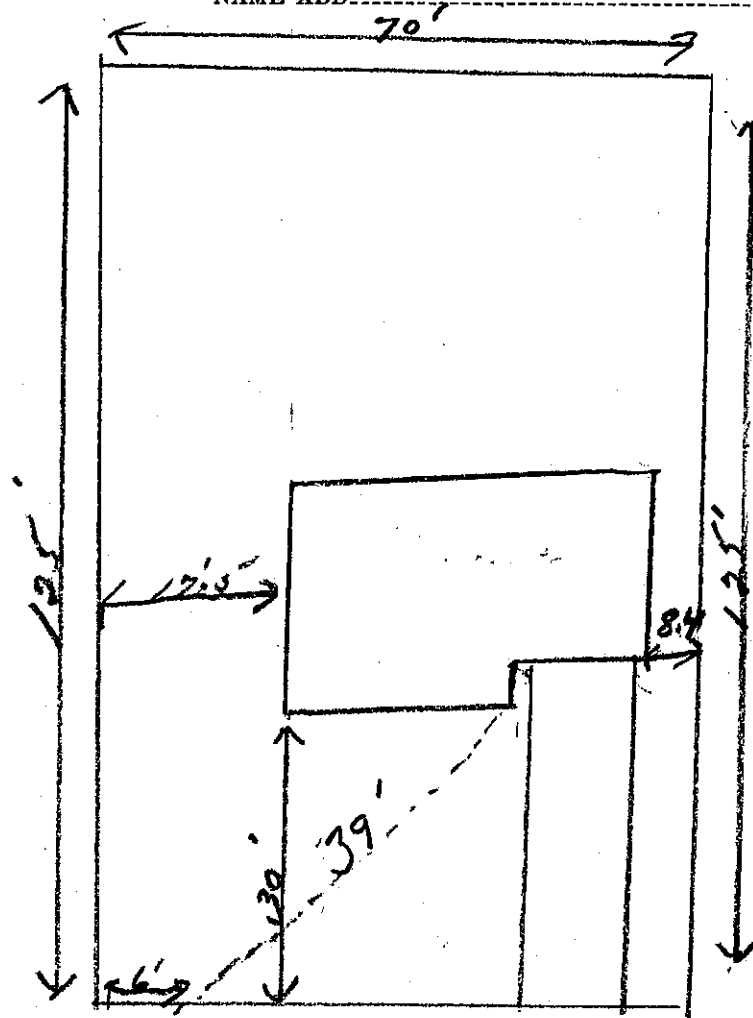

2183
Bldg-Permit

BACKFILL WORK ORDER ISSUED _____ DEPOSIT, \$ _____

SEWER WORK ORDER ISSUED _____

Date

Approved:

DATE 4/27/62 BY George W. Baker