


3' Spot repair w/ Cleanout install.

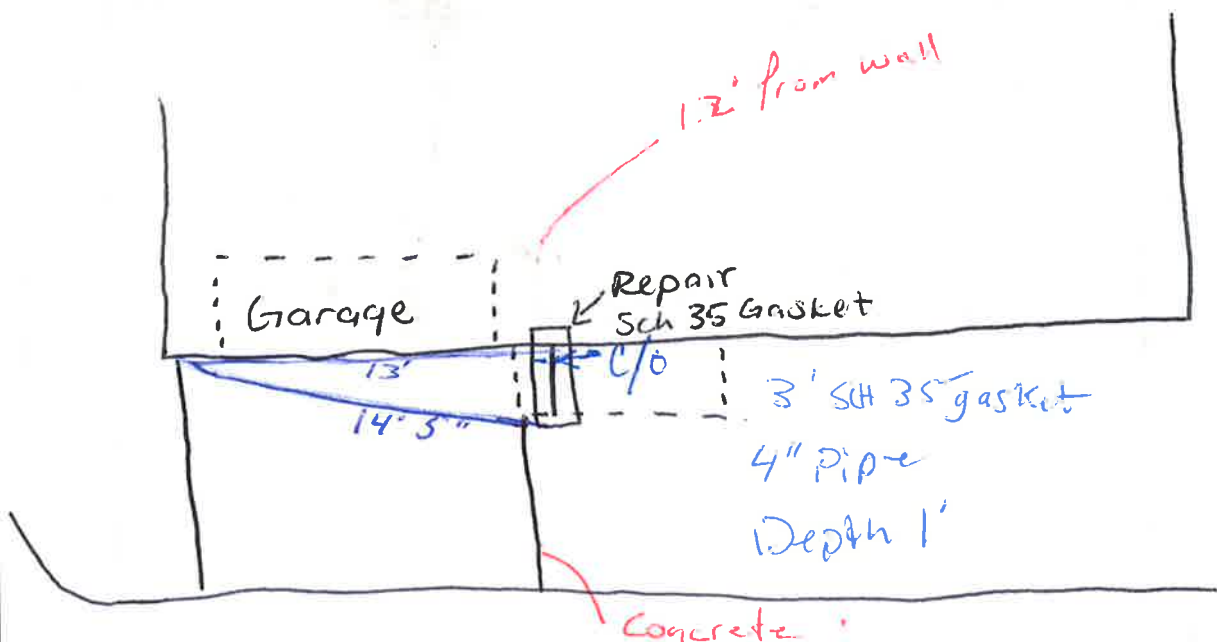

6705



228th St SW

OWNER:

ADDRESS:

DATE:

PERMIT #:

Inspector's Signature:

SIDE SEWER DRAWING

1. Drawing must be clearly labeled (streets, north arrow).
2. Indicate location of all piping, cleanouts, manholes or other fixed features.
3. Dimension pipe length and distance from other features.
4. Label diameter, bends, material type of pipe and depth at cleanouts.

 MOUNTLAKE
TERRACE



CALL BEFORE YOU
DIG:
1-800-424-5555 (or 811)