

The City of Montlake Terrace

for
SIDE SEWER PERMIT
OUTSIDE ☒ INSIDE ☐ REPAIRS ☐

CARD No. _____

EASEMENT No. _____


OWNER _____ CONTRACTOR Lin Homes Lynnwood Septic Tank

U 22 77
PERMIT No. _____

HOUSE No. 4510 225th Pl SW

STREET
AVENUE LOT No. 7 Hidden Highlands No 2 BLOCK No. _____

NAME ADD _____

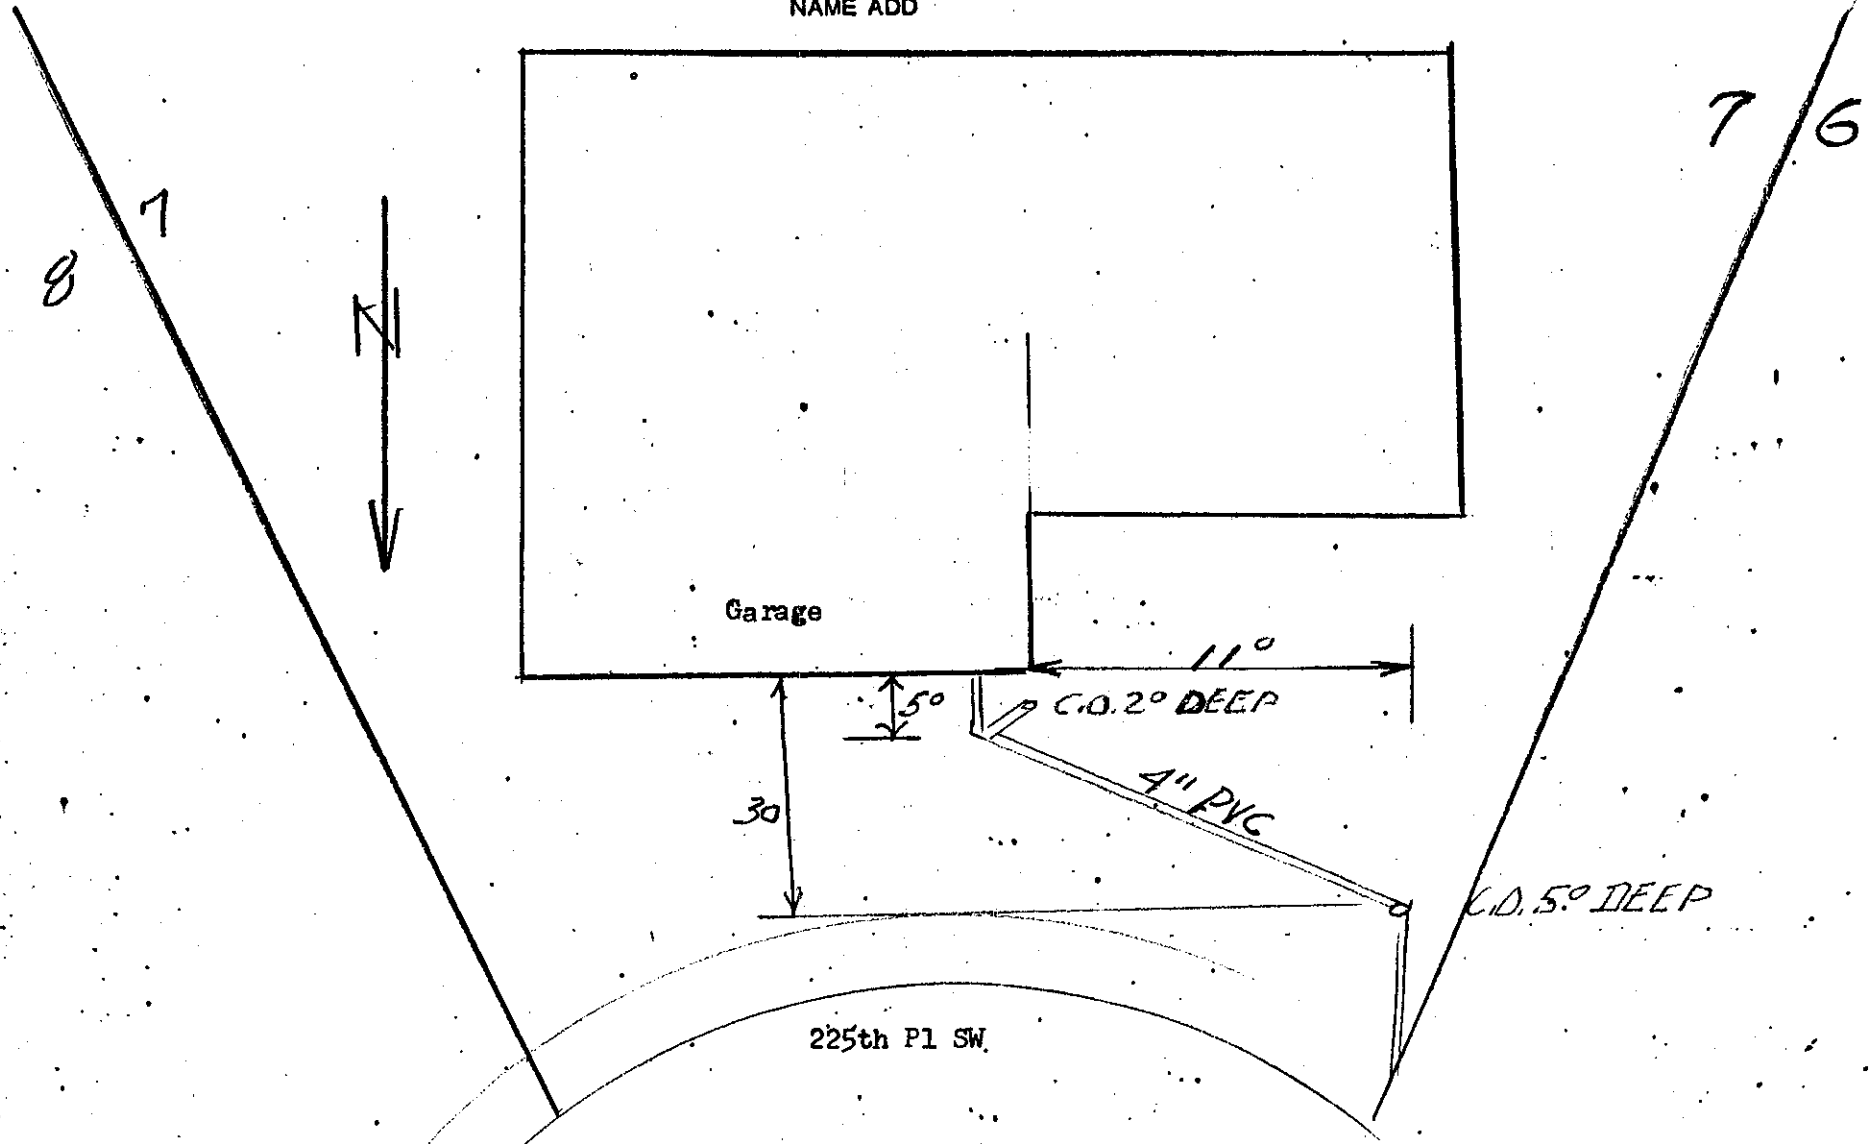

BACKFILL WORK ORDER ISSUED 3 22 77 Date
SEWER WORK ORDER ISSUED 3 18 77 DEPOSIT, \$ 10

Approved:

DATE 3 22 77

BY

Handwritten signature