


see 22219-66th Ave

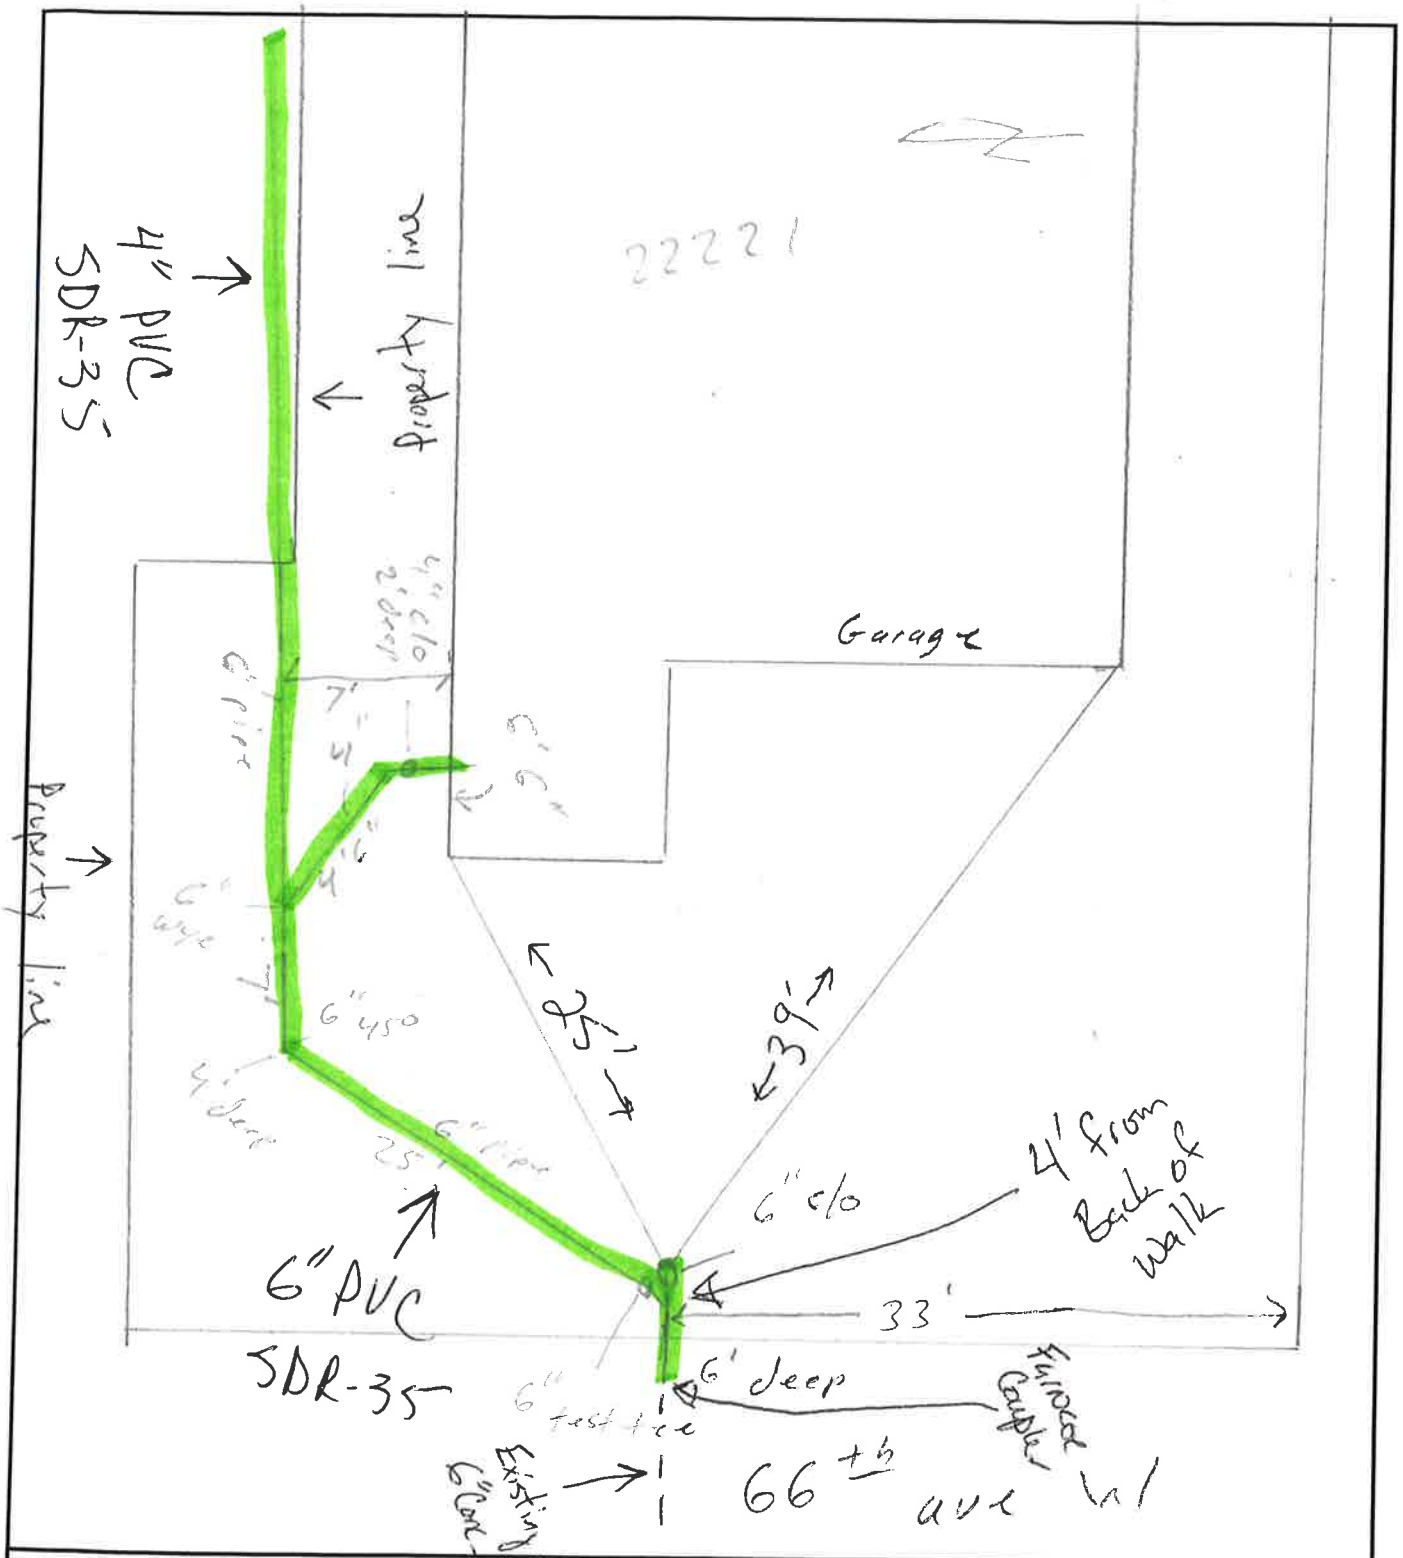

OWNER: RA Crosby IRA LLC

ADDRESS: 22221 66th Ave NW

DATE: 6/20/17

PERMIT #: U-17-0027

Inspector's Signature: Louis A. Mahul

SIDE SEWER DRAWING

1. Drawing must be clearly labeled (streets, north arrow).
2. Indicate location of all piping, cleanouts, manholes or other fixed features.
3. Dimension pipe length and distance from other features.
4. Label diameter, bends, material type of pipe and depth at cleanouts.



CALL BEFORE YOU DIG:
1-800-424-5555 (or 811)