

The City of Mountlake 1

APPLICATION

for

SIDE SEWER PERMIT

OUTSIDE ☐ INSIDE ☐ REPAIRS ☐

EASEMENT

No.

OWNER

Wick Co Inc

CONTRACTOR

Lynnwood Septic Tank Co

PERMIT No.

3718

HOUSE No.

21404 54th plr

STREET


AVENUE LOT No.

Lot 2

BLOCK No.

NAME ADD.

Shadet

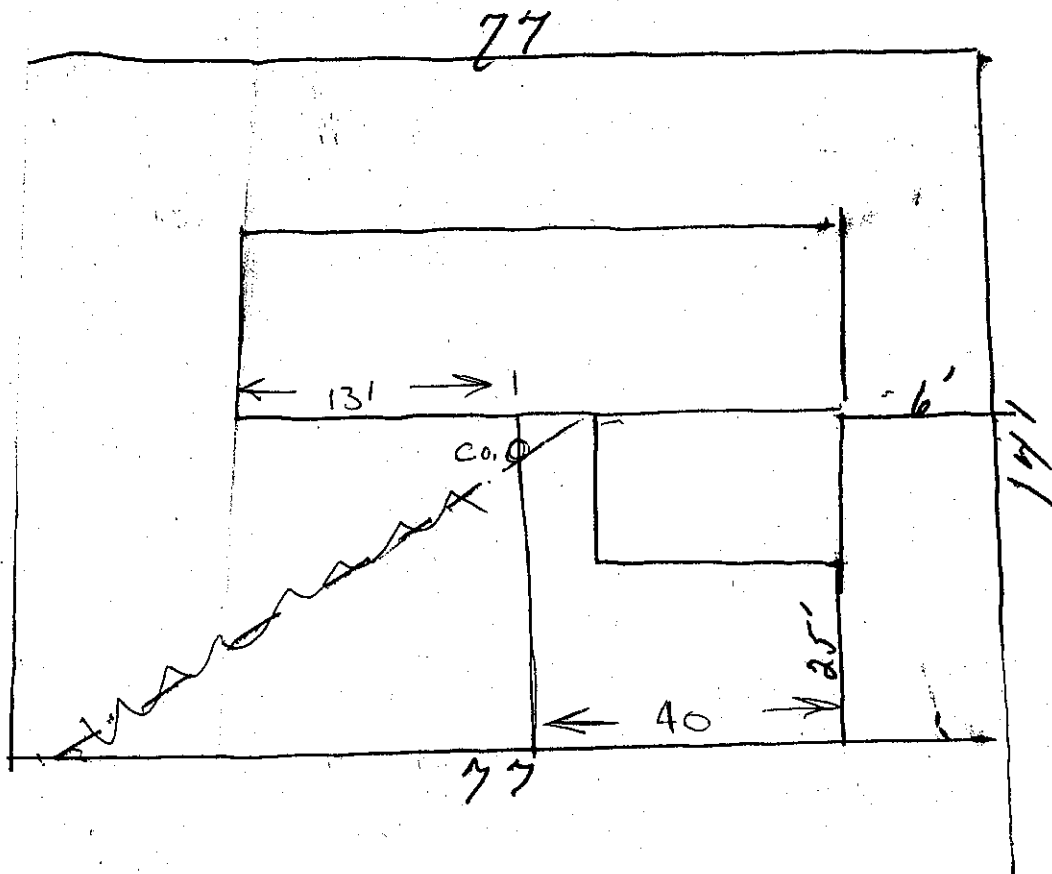

BACKFILL WORKORDER ISSUED
SEWER WORK ORDER ISSUED

Date

DEPOSIT, \$

Approved:

DATE

3-5-69

BY

[Signature]