

APPLICATION

The City of Mountlake Terrace


SIDE SEWER PERMIT

OUTSIDE ☐ INSIDE ☐ REPAIRS ☐

CARD No. _____

EASEMENT No. _____

OWNER Parkwood Homes Inc CONTRACTOR Lynnwood Septic PERMIT No. 3946
 HOUSE No. 4407 2195W STREET 4 BLOCK No. 14477
 AVENUE LOT No. 4
 NAME ADD Parkwood lanes

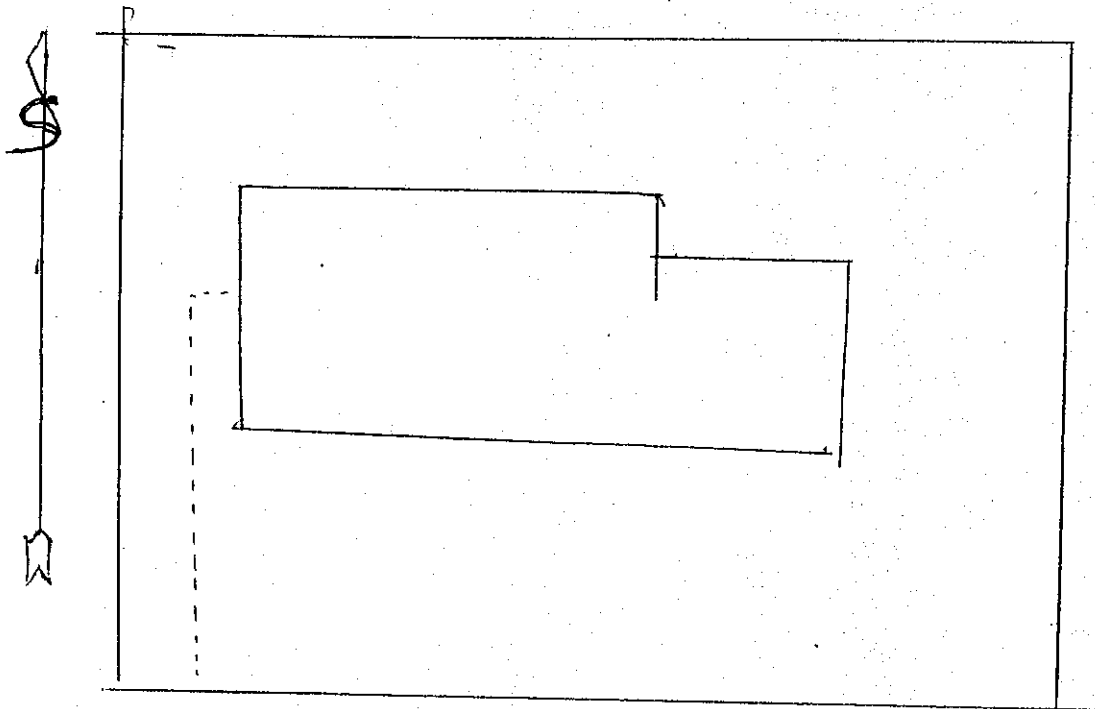

CITY OF
MOUNTLAKE TERRACE

BACKFILL WORK ORDER ISSUED _____ Date _____ DEPOSIT, \$ _____
 SEWER WORK ORDER ISSUED _____

Approved: _____
 DATE _____ BY _____ Plan Approved George N. Baker
 JUN 3 1965